

STATE ENGINEER
Salem, Oregon

Registration Statement

OF CLAIMANT OF RIGHT TO APPROPRIATE GROUND WATER

TO THE STATE ENGINEER OF OREGON:

I, Maynard E. Stutzman

of Rt 1 box 286, Talent, Ore

(Mailing address)

County of Jackson

State of Oregon

do hereby make application for a certificate of registration as evidence of a right to appropriate ground water.

1. Source from which water is withdrawn is Infiltration pit

(Flowing well, pump well, infiltration trench, or tunnel)

2. Location is: One (1) mile NE of Talent

(Approximate distance and direction from nearest city or town)

and is more particularly described as follows:

(a) 1,000 ft N. 500 ft. E. of SW cor JLC 80

(Give distance and bearing to corner of section or other legal subdivision)

being within SE 1/4, 31st

(Smallest legal subdivision)

of Sec. 14

Twp. 38S

Rge. 1W

(N. or S.)

(E. or W.)

or (b) within limits of recorded platted property, town or city:

in Lot 54

Block

of Royal Orchard Tract No 3

(Name of plat or addition)

County of Jackson

(If within city or town, give name)

3. Construction Work was begun on 1942

(Date)

; was completed on 1942

(Date)

and the ground water claimed was first used for the purposes set out below on 1942

(Date)

since which time the water has been used intermittently

(Continuously or intermittently)

from 1942

(Date)

to 1957

(Date)

4. Quantity of water claimed and used is 240 gallons per minute;

gallons per minute;

18 acre

feet per year.

5. Purpose or Purposes for which water is used

irrigation

(Domestic, irrigation, municipal, manufacturing, industrial, etc.)

6. Description of Well: Depth (Does not apply) feet. Type

(Does not apply)

(Dug or drilled)

diameter _____ inches. Elevation of ground at well site

_____ feet, mean sea level.

(As near as known)

Depth to water table _____ feet.

7. Capacity of Well: _____ g.p.m. with _____ feet drawdown.

(Does not apply)

_____ g.p.m. with _____ feet drawdown.

Date of test _____

If Flowing Well: Measured discharge _____ g.p.m. on _____

(Date)


Shut-in pressure at ground surface _____ lbs. per sq. in. on _____

(Date)

Water is controlled by _____

(Cap, valve, etc.)

Township 383 Range 1W, W.M.
North

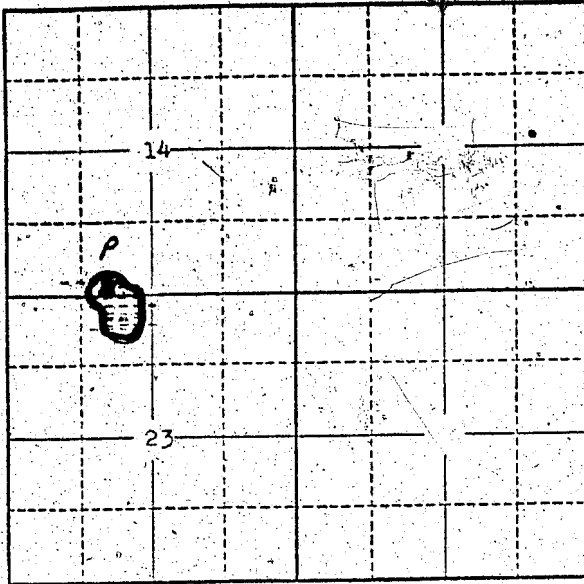

Locate well and acreage of irrigated land on plat.
Scale: 2" = 1 Mile

STATE OF OREGON

County of Jackson

ss.

I, Maynard M. Stutzman, being first duly sworn, do hereby certify that I have read the foregoing Registration Statement and that all of the items therein contained are true to the best of my knowledge and belief.

Maynard M. Stutzman
(Signature of Registrant)

Subscribed and sworn to before me this 21 day of February, 1958.

My commission expires March 19, 1961

G. G. Keese
(Notary Public)

(SEAL)

CERTIFICATE OF REGISTRATION

STATE OF OREGON

County of Marion

ss.

This is to certify that the foregoing Registration Statement was received in the office of the State Engineer on the 26th day of March, 1958, at 8:00 o'clock A. M. and has been duly recorded in said office in Book No. 6 of Registration Statements on page GR-1225

Witness my hand this 19 day of September, 1958.

Lewis A. Stanley
(State Engineer)

By

(Deputy)

GR - 1225

150