

RECEIVED
MAR 26 1958
STATE ENGINEER
SALEM, OREGON

Registration No. GR. - 1272

Certificate No. GR. - 1228

Registration Statement

OF CLAIMANT OF RIGHT TO APPROPRIATE GROUND WATER

TO THE STATE ENGINEER OF OREGON:

I, Clayton C. Bryan

of Route 1 Box 642 Eugene Oregon County of Linn

State of Oregon, do hereby make application for a certificate of registration as evidence of a right to appropriate ground water.

1. Source from which water is withdrawn is Pump Well #1
(Flowing well, pump well, infiltration trench, or tunnel)
2. Location is: 8 miles North West of Eugene
(Approximate distance and direction from nearest city or town)

and is more particularly described as follows:

(a) 750 S. & 300' E. of E 1/4 Corner Sec. 8
~~Sec. 8 Twp. 17S Rge. 4W W.M.~~
(Give distance and bearing to corner of section or other legal subdivision)

being within SE 1/4 of SW 1/4 NW 1/4 Sec. 8, Twp. 17S, Rge. 4W W.M.
(Smallest legal subdivision) (N. or S.) (E. or W.)

or (b) within limits of recorded platted property; town or city: _____

in Lot _____, Block _____ of _____
(Name of plat or addition)

County of _____
(If within city or town, give name)

3. Construction Work was begun on Dec. 1954; was completed on Jan. 1955
(Date) (Date)

and the ground water claimed was first used for the purposes set out below on Summer 1958
(Date)

since which time the water has been used intermittently
(Continuously or intermittently)

from Summer 1958 to Oct 1
(Date) (Date)

4. Quantity of water claimed and used is 150 200 gallons per minute; 62.5 acre feet per year.

5. Purpose or Purposes for which water is used irrigation

(Domestic, irrigation, municipal, manufacturing, industrial, etc.)

6. Description of Well: Depth 2075 feet. Type Dug
(Dug or drilled)

diameter 40 x 100 inches. Elevation of ground at well site 3651 feet, mean sea level.
(As near as known)

Depth to water table 42 feet.

7. Capacity of Well: 150 g.p.m. with 10 feet drawdown.

_____ g.p.m. with _____ feet drawdown.

Date of test Jan 1 1954

If Flowing Well: Measured discharge _____ g.p.m. on _____
(Date)

Shut-in pressure at ground-surface _____ lbs. per sq. in. on _____
(Date)

Water is controlled by _____
(Cap, valve, etc.)

8. Casing: (Give diameter, commercial specifications and depth below ground surface of each casing size.)

..... inch diameter from to feet
..... inch diameter from to feet
..... inch diameter from to feet
..... inch diameter from to feet

Describe and show depth of shoe, plug, adapter, liner or other details:

9. Perforated Casings or Screens:

..... (Number per foot and size of perforations, or describe screen) from to
..... from to
..... from to
..... from to

10. Log of Well: (Describe each stratum or formation clearly, indicate if water bearing, and give thickness and depth as indicated.)

MATERIAL	Thickness (Feet)	Depth to Bottom (Feet)

If log of well is not available, give name and address of driller.

11. Infiltration Trench: Covered or open

Dimensions: Length ft. Minimum depth ft. Maximum depth ft.

Bottom width ft. Discharge g.p.m. Date of test

12. Tunnel: Type of lining

Dimensions:
(Length, course, and cross sectional size)

Position of water bearing stratum with reference to portal of tunnel

Log of tunnel: (Preceding table for log of well may be used, if desired. Give footage from portal and character of materials, as pertinent.)

13. Pumping Equipment:

(a) Pump *Berkelung 2" centrifugal* Capacity *150* g.p.m.
(Make, type and size)


(b) Motor *10 H.P. 3 phase*
(Type and horsepower)

14. Location of area irrigated or to be irrigated, or place of use if for purposes other than irrigation.

Township North or South	Range E. or W. of Williamsite Meridian	Section	Forty-acre Tract	Number Acres To Be Irrigated	Date of Reclamation
17S	4W-WM	8	<i>N1/4 of SW 1/4</i>	<i>25 acres</i>	<i>Aug 20, 1954</i>

15. If the ground water supply is supplemental to an existing water supply, identification of any application for a permit, permit, certificate or adjudicated right to appropriate water made or held by the registrant.

Township 17 S Range 4 W W.M.
North

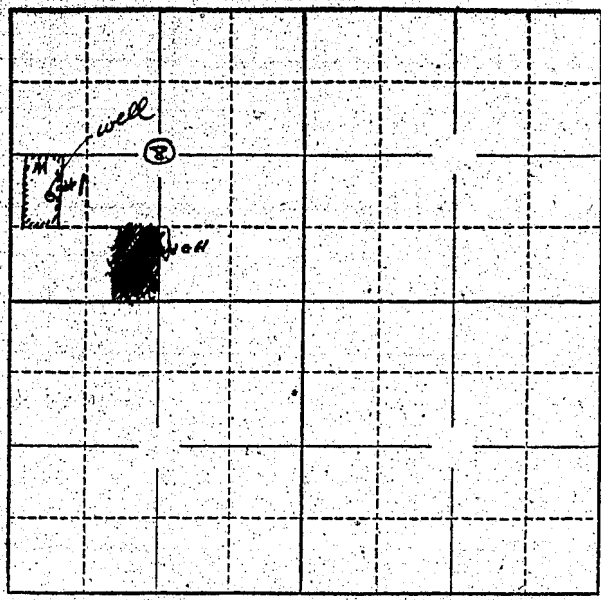

Locate well and acreage of irrigated land on plat.
Scale: 2" = 1 Mile

STATE OF OREGON

County of Clatsop } ss.

I, CLAYTON BRYAN, being first duly sworn, do hereby certify that I have read the foregoing Registration Statement and that all of the items therein contained are true to the best of my knowledge and belief.

Clayton Bryan
(Signature of Registrant)

Subscribed and sworn to before me this 14th day of March, 1958

My commission expires June 25, 1961 Luella J. Hensen
(Notary Public)

(SEAL)

CERTIFICATE OF REGISTRATION

STATE OF OREGON

County of Marion } ss.

This is to certify that the foregoing Registration Statement was received in the office of the State Engineer on the 26th day of March, 1958, at 1.00 o'clock P. M. and has been duly recorded in said office in Book No. 6 of Registration Statements on page GR-1228

Witness my hand this 19 day of September, 1958

Lewis A. Stanley
(State Engineer)

By _____
(Deputy)