

# Registration Statement

## OF CLAIMANT OF RIGHT TO APPROPRIATE GROUND WATER

### TO THE STATE ENGINEER OF OREGON:

I, Herman J. Freudenthal  
 of 2220 SW Minter Bridge Rd. County of Washington  
(Mailing address)  
 State of Oregon, do hereby make application for a certificate of registration as evidence of a right to appropriate ground water.

1. Source from which water is withdrawn is Pump Well # 2  
(Flowing well, pump well, infiltration trench, or tunnel)  
 2. Location is: S.E. city limits of Hillsboro, Oregon  
(Approximate distance and direction from nearest city or town)

and is more particularly described as follows:

(a) S 12° W - 1090' from N 1/4 corner Section 8  
(Give distance and bearing to corner of section or other legal subdivision)  
 being within NE 1/4 NW 1/4 of Sec. 8, Twp. 1S, Rge. 2W  
(Smallest legal subdivision) (N. or S.) (E. or W.)  
 or (b) within limits of recorded platted property, town or city:  
 in Lot \_\_\_\_\_, Block \_\_\_\_\_ of \_\_\_\_\_  
(Name of plat or addition)  
 County of \_\_\_\_\_  
(If within city or town, give name)

3. Construction Work was begun on June 1953; was completed on July 1953  
(Date) (Date)  
 and the ground water claimed was first used for the purposes set out below on Aug 1953  
(Date)  
 since which time the water has been used intermittently during season  
(Continuously or intermittently)  
 from Aug 1953 to Sept 1957  
(Date) (Date)

4. Quantity of water claimed and used is 150 gallons per minute; 100 acre feet per year.

5. Purpose or Purposes for which water is used Irrigation  
(Domestic, irrigation, municipal, manufacturing, industrial, etc.)

6. Description of Well: Depth 195 feet. Type Drilled  
(Dug or drilled)  
 diameter 10 inches. Elevation of ground at well site \_\_\_\_\_ feet, mean sea level.  
(As near as known)  
 Depth to water table 18 feet. July


7. Capacity of Well: 150 g.p.m. with 82 feet drawdown.  
 \_\_\_\_\_ g.p.m. with \_\_\_\_\_ feet drawdown.

Date of test \_\_\_\_\_  
 If Flowing Well: Measured discharge \_\_\_\_\_ g.p.m. on \_\_\_\_\_  
(Date)  
 Shut-in pressure at ground surface \_\_\_\_\_ lbs. per sq. in. on \_\_\_\_\_  
(Date)  
 Water is controlled by \_\_\_\_\_  
(Cap. valve, etc.)





Township 1S Range 2W, W.M.  
North.

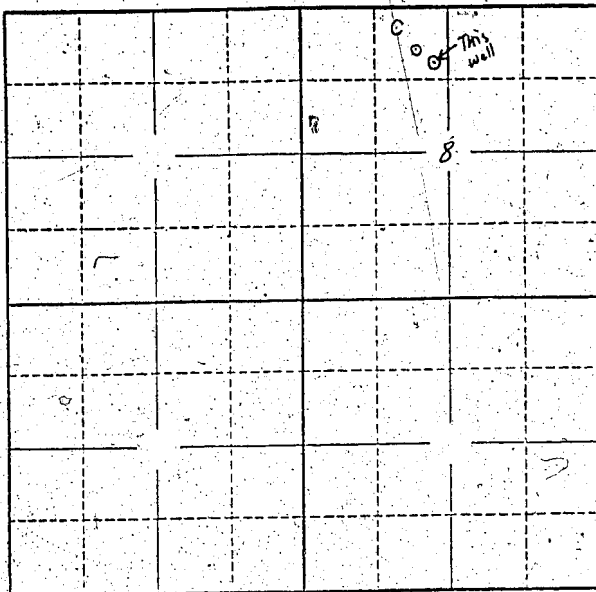

Locate well and acreage of irrigated land on plat.  
Scale: 2" = 1 Mile

STATE OF OREGON

County of Washington

ss.

I, Herman Freudenthal, being first duly sworn, do hereby certify that I have read the foregoing Registration Statement and that all of the items therein contained are true to the best of my knowledge and belief.

Herman Freudenthal  
(Signature of Registrant)

Subscribed and sworn to before me this 26 day of March, 1958.

expires Dec. 7-1959

Claydel Hunt  
(Notary Public)



**CERTIFICATE OF REGISTRATION**

OREGON

ss.

This is to certify that the foregoing Registration Statement was received in the office of the State Engineer on the \_\_\_\_\_ day of \_\_\_\_\_, 19\_\_\_\_, at \_\_\_\_\_ o'clock \_\_\_\_\_ M. and has been duly recorded in said office in Book No. 6 of Registration Statements on page GR-1233

Witness my hand this 19 day of September, 1958

Lura A. Stanley  
(State Engineer)

By \_\_\_\_\_ (Deputy)

GR 1233