

Registration No. GR - 1277

Certificate No. GR - 1453

Registration Statement

OF CLAIMANT OF RIGHT TO APPROPRIATE GROUND WATER

TO THE STATE ENGINEER OF OREGON:

I, Paul J. and Thelma M. Senko
of Rt 2 Forest Grove County of Washington
(Mailing address)

State of Oregon, do hereby make application for a certificate of registration as evidence of a right to appropriate ground water.

1. Source from which water is withdrawn is pump well #1
(Flowing well, pump well, infiltration trench, or tunnel)

2. Location is: Adjoining East City limits of Forest Grove
(Approximate distance and direction from nearest city or town)

and is more particularly described as follows: 422' x 23' N 1722.61' from SE Cor Section 32
T1N23W

(a) ~~422' x 23' N 1722.61' from SE Cor Section 32~~
(Give distance and bearing to corner of section or other legal subdivision)

being within SE 1/4 of SW 1/4 of Sec. 32, Twp. 1 N., Rge. 3 W.
(Smallest legal subdivision) (N. or S.) (E. or W.)

or (b) within limits of recorded platted property, town or city: _____

in Lot _____, Block _____ of _____
(Name of plat or addition)

County of _____
(If within city or town, give name)

3. Construction Work was begun on 5/31/40; was completed on 11/5/40
(Date) (Date)

and the ground water claimed was first used for the purposes set out below on December 1940
(Date)

since which time the water has been used Continuously
(Continuously or intermittently)
from Dec 1940 to Mar 1957
(Date) (Date)

4. Quantity of water claimed and used is 60 gallons per minute; 1 1/4 acre feet per year.

5. Purpose or Purposes for which water is used Irrigation & Domestic
(Domestic, irrigation, municipal, manufacturing, industrial, etc.)

6. Description of Well: Depth 285 feet. Type drilled
(Dug or drilled)

diameter 12 inches. Elevation of ground at well site 200 feet, mean sea level.
(As near as known)

Depth to water table 15 feet.

7. Capacity of Well: Do not know g.p.m. with _____ feet drawdown.
_____ g.p.m. with _____ feet drawdown.


Date of test Dec 3 1940

If Flowing Well: Measured discharge _____ g.p.m. on _____
(Date)

Shut-in pressure at ground surface _____ lbs. per sq. in. on _____
(Date)

Water is controlled by _____
(Cap, valve, etc.)

Township 1N Range 3W, W.M.
North

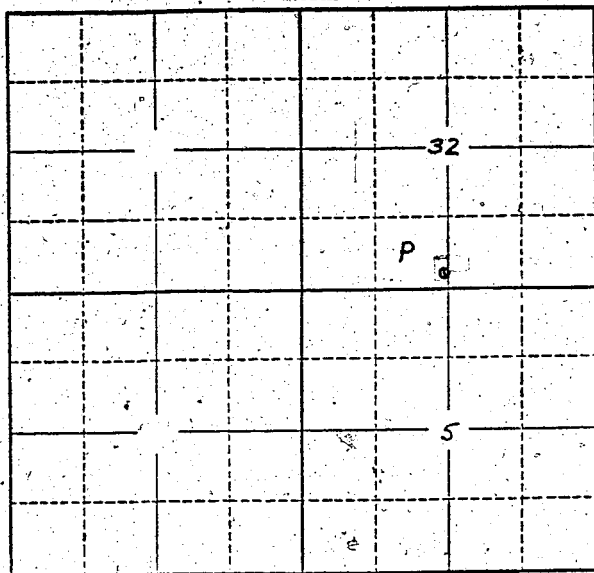

Locate well and acreage of irrigated land on plat.
Scale: 2" = 1 Mile

STATE OF OREGON }
County of Marion } ss.

I, _____, being first duly sworn, do hereby certify that I have read the foregoing Registration Statement and that all of the items therein contained are true to the best of my knowledge and belief.

Paul Senko
(Signature of Registrant)

Subscribed and sworn to before me this 26th day of March, 1958.

My commission expires 12th June 1961 Wm. J. Bartholomew
(Notary Public)

(SEAL)

CERTIFICATE OF REGISTRATION

STATE OF OREGON }
County of Marion } ss.

This is to certify that the foregoing Registration Statement was received in the office of the State Engineer on the 26th day of March, 1958, at 8:00 o'clock A. M. and has been duly recorded in said office in Book No. 7 of Registration Statements on page GR-1453

Witness my hand this _____ day of _____ December, 1958.
Lewis A. Stanley
(State Engineer)

By _____
(Deputy)

GR - 1453

#1055