

Registration Statement**OF CLAIMANT OF RIGHT TO APPROPRIATE GROUND WATER**

(Under Chapter 708, Oregon Laws 1955.)

TO THE STATE ENGINEER OF OREGON:I, William H. Brindleof Garvais County of MarionState of Oregon do hereby make application for a certificate of registration as evidence of a right to appropriate ground water.1. Source from which water is withdrawn is pump well

(Flowing well, pump well, infiltration trench, or tunnel)

2. Location is: 3 1/4 mi. SW of Garvais, Oregon

(Approximate distance and direction from nearest city or town)

and is more particularly described as follows:

(a) well is 2750' S and 700' W of NE 207, 02 S 32, 5 S, 2 1/2 W

(Give distance and bearing to corner of section or other legal subdivision)

being within East of Sec. 33, Twp. 30, Rge. 2

(Smallest legal subdivision)

(N. or S.)

(E. or W.)

or (b) within limits of recorded platted property, town or city: 6

in Lot _____, Block _____ of _____

(Name of plat or addition)

County of _____

(If within city or town, give name)

3. Construction Work was begun on April 1954; was completed on May 1954

(Date)

(Date)

and the ground water claimed was first used for the purposes set out below on June 1954

(Date)

since which time the water has been used continuously during the irrigation season

(Continuously or intermittently)

from June 1954 to late

(Date)

(Date)

4. Quantity of water claimed and used is 1000 gallons per minute; _____ acre feet per year.5. Purpose or Purposes for which water is used irrigation

(Domestic, irrigation, municipal, manufacturing, industrial, etc.)

6. Description of Well: Depth 101 feet. Type drilled

(Dug or drilled)

diameter 12 inches. Elevation of ground at well site 170 feet, mean sea level.

(As near as known)

Depth to water table 36 feet.7. Capacity of Well: 1000 g.p.m. with 40 feet drawdown.

_____ g.p.m. with _____ feet drawdown.

Date of test May 12, 1954

If Flowing Well: Measured discharge _____ g.p.m. on _____

(Date)

Shut-in pressure at ground surface _____ lbs. per sq. in. on _____

(Date)

Water is controlled by _____

(Cap, valve, etc.)

If log of well is not available, give name and address of driller.

Irving Sears Rt. 1 Gervais, Oregon

11. Infiltration Trench: Covered or open

Dimensions: Length _____ ft. Minimum depth _____ ft. Maximum depth _____ ft.

Bottom width _____ ft. Discharge _____ g.p.m. Date of test _____

12. Tunnel: Type of lining

Dimensions: _____
(Length, course, and cross sectional size)

Position of water bearing stratum with reference to portal of tunnel

Log of tunnel: (Preceding table for log of well may be used, if desired. Give footage from portal and character of materials, as pertinent.)

13. Pumping Equipment:

(a) Pump *Fairbanks-Morse ? Turbine* Capacity *1100* g.p.m.
(Make, type and size)


(b) Motor *35 H.P. Electric Motor*
(Type and horsepower)

14. Location of area irrigated or to be irrigated, or place of use if for purposes other than irrigation.

Township North or South	Range E. or W. of Willamette Meridian	Section	Forty-acre Tract	Number Acres To Be Irrigated	Date of Reclamation
5 S	3 W	22	SW ¹ - NE ⁴	22.5	June 1911
"	"	4	SE ¹ - NE ¹	22.5	"
"	"	4	SW ¹ - SE ¹	22.5	"
"	"	4	SW ¹ - SW ¹	22.5	"
"	"	23	SW ¹ - SW ¹	5.0	"
"	"	5	SW ¹ - SW ¹	5.0	"
				<u>100.0</u>	

15. If the ground water supply is supplemental to an existing water supply, identification of any application for a permit, permit, certificate or adjudicated right to appropriate water made or held by the registrant.

Township 5 S Range 2 W, W.M.
North

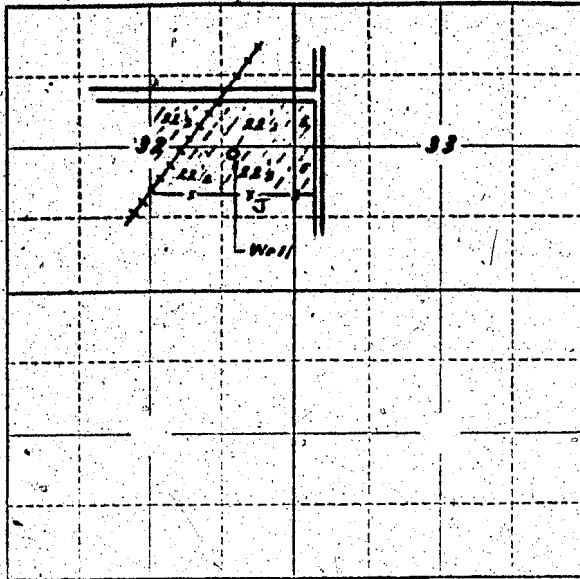

Locate well and acreage of irrigated land on plat.
Scale: 2" = 1 Mile

STATE OF OREGON

County of Union } ss.

I, William H. Jaille, being first duly sworn, do hereby certify that I have read the foregoing Registration Statement and that all of the items therein contained are true to the best of my knowledge and belief.

William H. Jaille
(Signature of Registrant)

Subscribed and sworn to before me this 25th day of March, 1955.

My commission expires Aug 10, 1960.
Ernie E. Maltz
(Notary Public for Oregon)

(SEAL)

CERTIFICATE OF REGISTRATION

STATE OF OREGON } ss.
County of Marion

This is to certify that the foregoing Registration Statement was received in the office of the State Engineer on the 26th day of March, 1955, at 1:00 o'clock P. M. and has been duly recorded in said office in Book No. 6 of Registration Statements on page GR-1210.

~~Consumption shall be completed by _____ and the water completely applied to _____~~

Witness my hand this 19 day of September, 1958.
Laura A. Stanley
(State Engineer)

By _____
GR-1210