

15  
State of Oregon  
STATE ENGINEER  
SALES OFFICE  
Registration No. GR - 1288

Certificate No. GR - 1215

# Registration Statement

## OF CLAIMANT OF RIGHT TO APPROPRIATE GROUND WATER

TO THE STATE ENGINEER OF OREGON:

I, LEVERIC W. BRAUN

of RT. 3-Box 182 County of Umatilla

State of Oregon, do hereby make application for a certificate of registration as evidence of a right to appropriate ground water.

1. Source from which water is withdrawn is Pump Well  
(Flowing well, pump well, infiltration trench, or tunnel)

2. Location is: 3 miles North of Milburg - Free water  
(Approximate distance and direction from nearest city or town)

and is more particularly described as follows:

(a) 1810 ft N and 754 ft W of the S 1/4 cor. of Sec 23  
(Give distance and bearing to corner of section or other legal subdivision)

being within NE 1/4 SW 1/4 of Sec. 23 Twp. 6 N Rge. 35 E  
(Smallest legal subdivision) (N. or S.) (E. or W.)

or (b) within limits of recorded platted property, town or city:

in Lot \_\_\_\_\_, Block \_\_\_\_\_ of \_\_\_\_\_  
(Name of plat or addition)

County of Umatilla

(If within city or town, give name)

3. Construction Work was begun on 1920; was completed on 1922  
(Date) (Date)

and the ground water claimed was first used for the purposes set out below on 1922  
(Date)

since which time the water has been used continuously, each irrig. season  
(Continuously or intermittently)

from 1920 to 1958  
(Date) (Date)

4. Quantity of water claimed and used is 56 gallons per minute; 24 acre feet per year.

5. Purpose or Purposes for which water is used irrigation

(Domestic, irrigation, municipal, manufacturing, industrial, etc.)

6. Description of Well: Depth 34 1/2 feet. Type Drilled  
(Dug or drilled)

diameter 8 inches. Elevation of ground at well site 875 feet, mean sea level.  
(As near as known)

Depth to water table 4 ft feet.

7. Capacity of Well: \_\_\_\_\_ g.p.m. with \_\_\_\_\_ feet drawdown.

\_\_\_\_\_ g.p.m. with \_\_\_\_\_ feet drawdown.

Date of test March 10, 1920

If Flowing Well: Measured discharge \_\_\_\_\_ g.p.m. on \_\_\_\_\_  
(Date)

Shut-in pressure at ground surface \_\_\_\_\_ lbs. per sq. in. on \_\_\_\_\_  
(Date)

Water is controlled by \_\_\_\_\_  
(Cap, valve, etc.)

8. Casing: (Give diameter, commercial specifications and depth below ground surface of each casing size.)

..... inch diameter *1 1/2* ..... from ..... to ..... feet  
..... inch diameter ..... from ..... to ..... feet  
..... inch diameter ..... from ..... to ..... feet  
..... inch diameter ..... from ..... to ..... feet

Describe and show depth of shoe, plug, adapter, liner or other details: .....  
.....  
.....

9. Perforated Casings or Screens:

*100* ..... from ..... to .....  
(Number per foot and size of perforations, or describe screen)  
..... from ..... to .....  
..... from ..... to .....  
..... from ..... to .....

10. Log of Well: (Describe each stratum or formation clearly, indicate if water bearing, and give thickness and depth as indicated.)

MATERIAL	Thickness (Feet)	Depth to Bottom (Feet)
<i>100</i>		

If log of well is not available, give name and address of driller. *not known*

11. Infiltration Trench: Covered or open \_\_\_\_\_  
 Dimensions: Length \_\_\_\_\_ ft. Minimum depth \_\_\_\_\_ ft. Maximum depth \_\_\_\_\_ ft.  
 Bottom width \_\_\_\_\_ ft. Discharge \_\_\_\_\_ g.p.m. Date of test \_\_\_\_\_

12. Tunnel: Type of lining \_\_\_\_\_  
 Dimensions: \_\_\_\_\_  
(Length, course, and cross sectional size)  
 Position of water bearing stratum with reference to portal of tunnel \_\_\_\_\_

Log of tunnel: (Preceding table for log of well may be used, if desired. Give footage from portal and character of materials, as pertinent.)

13. Pumping Equipment:  
 (a) Pump *Fairbanks-Morse - Model 12E4234* *Pomona-Turbine type KC* Capacity \_\_\_\_\_ g.p.m.  
(Make, type and size)  
 (b) Motor *1 1/2 H.P. electric motor*  
(Type and horsepower)


14. Location of area irrigated or to be irrigated, or place of use if for purposes other than irrigation.

Township North or South	Range E. or W. of Willamette Meridian	Section	Forty-acre Tract	Number Acres To Be Irrigated	Date of Reclamation
<i>6 N</i>	<i>35 E</i>	<i>23</i>	<i>SW 1/4 NE 1/4 SW 1/4</i>	<i>8.0</i>	<i>1920</i>

15. If the ground water supply is supplemental to an existing water supply, identification of any application for a permit, permit, certificate or adjudicated right to appropriate water made or held by the registrant.

*None*

Township 6 N Range 35 E, W.M.  
North

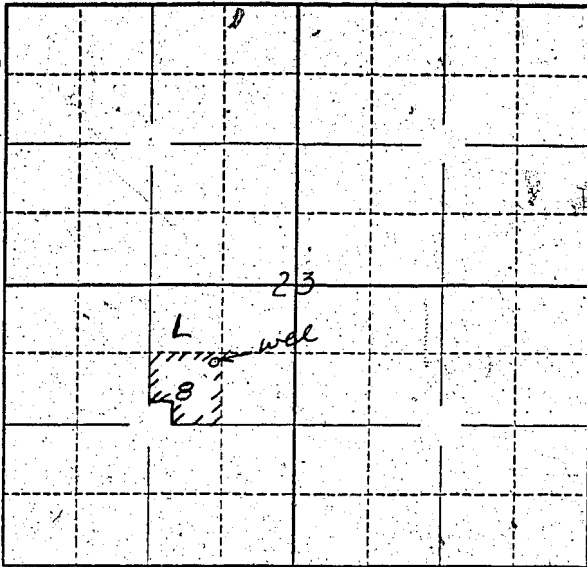

Locate well and acreage of irrigated land on plat.

Scale: 2" = 1 Mile

STATE OF OREGON

County of UMATILLA } ss.

I, LEWENE, being first duly sworn, do hereby certify that I have read the foregoing Registration Statement and that all of the items therein contained are true to the best of my knowledge and belief.

Lewene W. Brown  
(Signature of Registrant)

Subscribed and sworn to before me this 20 day of MARCH, 1954.

My commission expires AUG 10 1950

(Notary Public)

(SEAL)

**CERTIFICATE OF REGISTRATION**

STATE OF OREGON } ss.  
County of Marion

This is to certify that the foregoing Registration Statement was received in the office of the State Engineer on the 27th day of March, 1954, at 1.00 o'clock P. M. and has been duly recorded in said office in Book No. 6 of Registration Statements on page GR 1215

Witness my hand this 19 day of September, 1958

Lewis A. Stanley  
(State Engineer)

By \_\_\_\_\_ (Deputy)