

# Registration Statement

## OF CLAIMANT OF RIGHT TO APPROPRIATE GROUND WATER

TO THE STATE ENGINEER OF OREGON:

I, Albert W. & Ethel E. Moore  
of 673 E. MAIN St. Hillsboro County of WASHINGTON  
(Mailing address)

State of OREGON, do hereby make application for a certificate of registration as evidence of a right to appropriate ground water.

1. Source from which water is withdrawn is Pump Well #1  
(Flowing well, pump well, infiltration trench, or tunnel)
2. Location is: N.W. Corner 7th & E. Main St. Hillsboro  
(Approximate distance and direction from nearest city or town)

and is more particularly described as follows:

(a) Well located on Lot 8  
(u) From S.E. Corner Lot 8 121' N along Property Line thence West 41' to  
at S.E. Corner Garage (Give distance and bearing to corner of section or other legal subdivision)  
being within SW 1/4 SE 1/4 of Sec. 31, Twp. 1 N, Rge. 2 W  
(Smallest legal subdivision) (N. or S.) (E. or W.)

or (b) within limits of recorded platted property, town or city: of Hillsboro  
in Lot 7 & 8, Block 2 of Ennes Addition  
(Name of plat or addition)  
Hillsboro County of WASHINGTON  
(If within city or town, give name)

3. Construction Work was begun on June 1934; was completed on June 1934  
(Date) (Date)

and the ground water claimed was first used for the purposes set out below on June 1934  
(Date)  
since which time the water has been used Continuously  
(Continuously or intermittently)  
from June 1934 to present DATE (1954)  
(Date) (Date)

4. Quantity of water claimed and used is 20 gallons per minute; \_\_\_\_\_ acre feet per year.

5. Purpose or Purposes for which water is used Irrigation  
(Vegetable Garden 3rd Avenue)  
(Domestic, irrigation, municipal, manufacturing, industrial, etc.)

6. Description of Well: Depth 26 feet. Type Drilled  
(Dug or drilled)  
diameter 6 inches. Elevation of ground at well site 200 feet, mean sea level.  
(As near as known)  
Depth to water table 14 feet.

7. Capacity of Well: 20 g.p.m. with 8 feet drawdown.  
\_\_\_\_\_ g.p.m. with \_\_\_\_\_ feet drawdown.

Date of test Annual 1952

If Flowing Well: Measured discharge \_\_\_\_\_ g.p.m. on \_\_\_\_\_  
(Date)

Shut-in pressure at ground surface \_\_\_\_\_ lbs. per sq. in. on \_\_\_\_\_  
(Date)

Water is controlled by \_\_\_\_\_  
(Cap, valve, etc.)

8. Casing: (Give diameter, commercial specifications and depth below ground surface of each casing size.)

6 inch diameter *Steel Casing* from *Surface* to *26* feet  
 inch diameter from to feet  
 inch diameter from to feet  
 inch diameter from to feet

Describe and show depth of shoe, plug, adapter, liner or other details: *NONE*

9. Perforated Casings or Screens:

*NONE* from to  
(Number per foot and size of perforations, or describe screen)  
 from to  
 from to  
 from to

10. Log of Well: (Describe each stratum or formation clearly, indicate if water bearing, and give thickness and depth as indicated.)

MATERIAL	Thickness (Feet)	Depth to Bottom (Feet)
<i>Surface Soil</i>	<i>15'</i>	<i>15</i>
<i>Quicksand</i>	<i>4"</i>	<i>19</i>
<i>Clay</i>	<i>7'</i>	<i>26</i>
<i>Quicksand (WATER COMES FROM THIS STRATUM)</i>		

If log of well is not available, give name and address of driller. Fate Taylor

11. Infiltration Trench: Covered or open

Dimensions: Length \_\_\_\_\_ ft. Minimum depth \_\_\_\_\_ ft. Maximum depth \_\_\_\_\_ ft.

Bottom width \_\_\_\_\_ ft. Discharge \_\_\_\_\_ g.p.m. Date of test \_\_\_\_\_

12. Tunnel: Type of lining

Dimensions: \_\_\_\_\_  
(Length, course, and cross sectional size)

Position of water bearing stratum with reference to portal of tunnel \_\_\_\_\_

Log of tunnel: (Preceding table for log of well may be used, if desired. Give footage from portal and character of materials, as pertinent.)

13. Pumping Equipment:

(a) Pump Red Jacket JET Capacity 20 g.p.m.  
(Make, type and size)

(b) Motor 1 H.P. Electric (220 VAC)  
(Type and horsepower)


14. Location of area irrigated or to be irrigated, or place of use if for purposes other than irrigation.

Township North or South	Range E. or W. of Willamette Meridian	Section	Forty-acre Tract	Number Acres To Be Irrigated	Date of Reclamation
<u>1 N</u>	<u>2 W</u>	<u>31</u>	<u>SW 1/4 SE 1/4</u>	<u>0.75</u>	<u>June 1934</u>

15. If the ground water supply is supplemental to an existing water supply, identification of any application for a permit, permit, certificate or adjudicated right to appropriate water made or held by the registrant.

NONE

Township 1 N Range 2 W W.M.  
North

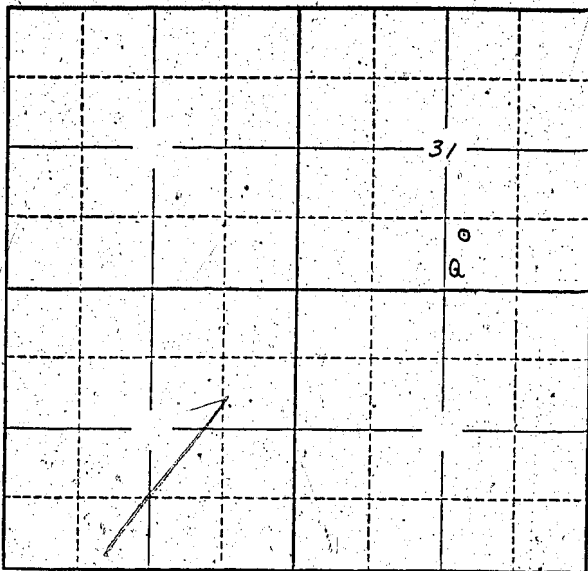

Locate well and acreage of irrigated land on plat.  
Scale: 2" = 1 Mile

STATE OF OREGON

County of Marion } ss.

I, \_\_\_\_\_ being first duly sworn, do hereby certify that I have read the foregoing Registration Statement and that all of the items therein contained are true to the best of my knowledge and belief.

Albert W. Zipp  
(Signature of Registrant)

Subscribed and sworn to before me this 26th day of March, 1958

My commission expires 12th June 1961

Wm. S. Bartholmeas  
(Notary Public)

(SEAL)

**CERTIFICATE OF REGISTRATION**

STATE OF OREGON

County of Marion } ss.

This is to certify that the foregoing Registration Statement was received in the office of the State Engineer on the 26th day of March, 1958, at 8:00 o'clock A.M. and has been duly recorded in said office in Book No. 6 of Registration Statements on page GR-1216

Witness my hand this 19 day of September, 1958

Lewis A. Stanley  
(State Engineer)

By \_\_\_\_\_ (Deputy)