

RECEIVED
FEB 20 1956
STATE ENGINEER
SALEM, OREGON

REGISTRATION NO. GR-129
CERTIFICATE NO. GR-120

Registration Statement

OF CLAIMANT OF RIGHT TO APPROPRIATE GROUND WATER

(Under Chapter 708, Oregon Laws 1955.)

TO THE STATE ENGINEER OF OREGON:

I, Joe H. Meyer & Lorraine A. Meyer
of Rt 1 Box 413 Talent County of Jackson
State of Oregon, do hereby make application for a certificate of registration as evidence
of a right to appropriate ground water.

1. Source from which water is withdrawn is Infiltration trench
(Flowing well, pump well, infiltration trench, or tunnel)

2. Location is: 1 mile west of Talent
(Approximate distance and direction from nearest city or town)

and is more particularly described as follows:

(a) 150 feet south and 280 feet east from center of section 28
lots 13, 14, 15, 16, 17, 18, 19, 20 and that portion of lot 21
the easterly of a section line (Give distance and bearing to corner of section or other legal subdivision)

being within NW 1/4 of SE 1/4 of Sec. 28 Twp. 3 S. Rge. 1 West
(Smallest legal subdivision) (N. or S) (E. or W)

or (b) within limits of recorded platted property, town or city:

in Lot _____, Block _____ of _____
(Name of plat or addition)

County of _____
(If within city or town, give name)

3. Construction Work was begun on Oct. 1954; was completed on Nov. 1954
(Date) (Date)

and the ground water claimed was first used for the purposes set out below on April 1955
(Date)

since which time the water has been used Continuously
(Continuously or intermittently)

from April 15 to Sept 30
(Date) (Date)

4. Quantity of water claimed and used is 3.50 gallons per minute; _____ acre
feet per year.

5. Purpose or Purposes for which water is used irrigation
(Domestic, irrigation, municipal, manufacturing, industrial, etc.)

6. Description of Well: Depth _____ feet. Type _____
(Dug or drilled)

diameter _____ inches. Elevation of ground at well site 1540 feet, mean sea level.
1940
(As near as known)

Depth to water table 0-12 feet.

7. Capacity of Well: _____ g.p.m. with _____ feet drawdown.

_____ g.p.m. with _____ feet drawdown.

Date of test _____

If Flowing Well: Measured discharge _____ g.p.m. on _____
(Date)

Shut-in pressure at ground surface _____ lbs. per sq. in. on _____
(Date)

Water is controlled by _____
(Cap, valve, etc.)

8. Casing: (Give diameter, commercial specifications and depth below ground surface of each casing size.)

inch diameter None from 0 to _____ feet
inch diameter _____ from _____ to _____ feet
inch diameter _____ from _____ to _____ feet
inch diameter _____ from _____ to _____ feet

Describe and show depth of shoe, plug, adapter, liner or other details:

9. Perforated Casings or Screens:

None from _____ to _____
(Number per foot and size of perforations, or describe screen)
from _____ to _____
from _____ to _____
from _____ to _____

10. Log of Well: (Describe each stratum or formation clearly, indicate if water bearing, and give thickness and depth as indicated.)

MATERIAL	Thickness (Feet)	Depth to Bottom (Feet)
No record		

If log of well is not available, give name and address of driller.

11. Infiltration Trench: Covered or open open
 Dimensions: Length 220 ft. Minimum depth 20 ft. Maximum depth 25 ft.
 Bottom width 45 ft. Discharge 350 g.p.m. Date of test

12. Tunnel: Type of lining
 Dimensions:
(Length, course, and cross sectional size)
 Position of water bearing stratum with reference to portal of tunnel

Log of tunnel: (Preceding table for log of well may be used, if desired. Give footage from portal and character of materials, as pertinent.)


13. Pumping Equipment:
 (a) Pump 3" Byron Jackson centrifugal Capacity 350 g.p.m.
(Make, type and size)
 (b) Motor 4 cylinder gas 4.5 hp
(Type and horsepower)

14. Location of area irrigated or to be irrigated, or place of use if for purposes other than irrigation.

Township North or South	Range E. or W. of Willamette Meridian	Section	Forty-acre Tract	Number Acres To Be Irrigated	Date of Reclamation
<u>38 south</u>	<u>17W</u>	<u>27</u>		<u>Total 60 acres</u>	<u>Oct. 1954</u>
"	"	"	<u>SW 1/4 of NE 1/4</u>	<u>33</u>	"
"	"	"	<u>NW 1/4 of NE 1/4</u>	<u>4 1/2</u>	"
"	"	"	<u>NW 1/4 of SE 1/4</u>	<u>7 1/2</u>	"
"	"	"	<u>NE 1/4 of NW 1/4</u>	<u>1 1/2</u>	"
"	"	"	<u>SE 1/4 of NW 1/4</u>	<u>11</u>	"
"	"	"	<u>NE 1/4 of SW 1/4</u>	<u>2 1/2</u>	"

15. If the ground water supply is supplemental to an existing water supply, identification of any application for a permit, permit, certificate or adjudicated right to appropriate water made or held by the registrant.

Township 3 P. S. Range 1 W., W.M.
North

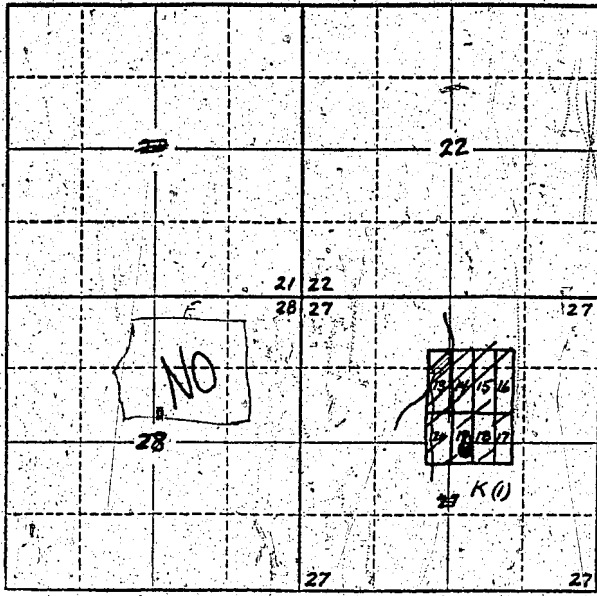

Locate well and acreage of irrigated land on plat.
Scale: 2" = 1 Mile

STATE OF OREGON

County of Jackson } ss.

I, Joe H. Meyer, being first duly sworn, do hereby certify that I have read the foregoing Registration Statement and that all of the items therein contained are true to the best of my knowledge and belief.

Joe H. Meyer
(Signature of Registrant)

Subscribed and sworn to before me this 15th day of February, 1956

My commission expires NOTARY PUBLIC FOR OREGON Fredrick C. Fungelja
My Commission Expires Mar. 1, 1957 (Notary Public)

(SEAL)

CERTIFICATE OF REGISTRATION

STATE OF OREGON

County of Marion } ss.

This is to certify that the foregoing Registration Statement was received in the office of the State Engineer on the 20th day of February, 1956, at 8:00 o'clock A. M. and has been duly recorded in said office in Book No. 1 of Registration Statements on page GR-120C.

~~Construction shall be completed by 1956 and the water completely applied to beneficial use by 1956~~

Witness my hand this 12th day of April, 1956

Lewis A. Stanley
(State Engineer)

By _____ (Deputy)