

Registration Statement

OF CLAIMANT OF RIGHT TO APPROPRIATE GROUND WATER

TO THE STATE ENGINEER OF OREGON:

I, R. L. Freeberg Gladys M. Freeberg
of 339-5th St Woodburn County of Marion
(Mailing address)

State of Oregon, do hereby make application for a certificate of registration as evidence of a right to appropriate ground water.

1. Source from which water is withdrawn is Pump Well #1
(Flowing well, pump well, infiltration trench, or tunnel)

2. Location is: 2 1/2 mi West of Middle of Geneva Oregon
(Approximate distance and direction from nearest city or town)

and is more particularly described as follows:

(a) 3.50 ft. West and 200 ft. North from the S.E. corner of the Sect 17,
(Give distance and bearing to corner of section or other legal subdivision)

being within S.E. 1/4 of S.W. 1/4 of Sec. 17, Twp. S.S., Rge. 2W
(Specify legal subdivision) (N. or S.) (E. or W.)

or (b) within limits of recorded platted property, town or city:

in Lot _____, Block _____ of _____
(Name of plat or addition)

County of _____
(If within city or town, give name)

3. Construction Work was begun on Jan 1945; was completed on Jan 1945
(Date) (Date)

and the ground water claimed was first used for the purposes set out below on May 1945
(Date)

since which time the water has been used intermittently during season
(Continuously or Intermittently)

from May 1945 to Oct 1957
(Date) (Date)

4. Quantity of water claimed and used is 30 gallons per minute; _____ acre feet per year.

5. Purpose or Purposes for which water is used Irrigation
(Domestic, irrigation, municipal, manufacturing, industrial, etc.)

6. Description of Well: Depth 107 feet. Type Drilled
(Dug or drilled)

diameter 6 inches. Elevation of ground at well site 176 feet, mean sea level.
(As near as known)

Depth to water table 18 feet. Summer

7. Capacity of Well: None g.p.m. with _____ feet drawdown.

_____ g.p.m. with _____ feet drawdown.

Date of test _____

If Flowing Well: Measured discharge _____ g.p.m. on _____
(Date)

Shut-in pressure at ground surface _____ lbs. per sq. in. on _____
(Date)

Water is controlled by _____
(Cap, valve, etc.)

8. Casing: (Give diameter, commercial specifications and depth below ground surface of each casing size.)

6 inch diameter Steel Casing from 0 to 107 feet
 inch diameter from to feet
 inch diameter from to feet
 inch diameter from to feet

Describe and show depth of shoe, plug, adapter, liner or other details: _____

9. Perforated Casings or Screens:

70 Open end Casing from to
 (Number per foot and size of perforations, or describe screen)
 from to
 from to
 from to

10. Log of Well: (Describe each stratum or formation clearly, indicate if water bearing, and give thickness and depth as indicated.)

MATERIAL	Thickness (Feet)	Depth to Bottom (Feet)
quick sand	70	90
Gravel Water bearing	90	107

If log of well is not available, give name and address of driller. *Ballweber James*

✓ 11. Infiltration Trench: Covered or open _____
 Dimensions: Length _____ ft. Minimum depth _____ ft. Maximum depth _____ ft.
 Bottom width _____ ft. Discharge _____ g.p.m. Date of test _____

12. Tunnel: Type of lining _____
 Dimensions: _____
(Length, course, and cross sectional size)
 Position of water bearing stratum with reference to portal of tunnel _____

Log of tunnel: (Preceding table for log of well may be used, if desired. Give footage from portal and character of materials, as pertinent.)


13. Pumping Equipment:
 (a) Pump *Jet* _____ Capacity *50* g.p.m.
(Make, type and size)
 (b) Motor *H.P.* _____
(Type and horsepower)

14. Location of area irrigated or to be irrigated, or place of use if for purposes other than irrigation.

Township North or South	Range E. or W. of Willamette Meridian	Section	Forty-acre Tract	Number Acres To Be Irrigated	Date of Reclamation
<i>T. 5 S</i>	<i>R. 2 W</i>	<i>17</i>	<i>S. E. 1/4, S. W. 1/4</i>	<i>6 AC</i>	<i>May 1940</i>
<i>T. 5 S</i>	<i>R. 2 W</i>	<i>17</i>	<i>S. W. 1/4, S. E. 1/4</i>	<i>1 AC.</i>	<i>May 1940</i>
				<i>7 AC.</i>	<i>May 1940</i>

15. If the ground water supply is supplemental to an existing water supply, identification of any application for a permit, permit, certificate or adjudicated right to appropriate water made or held by the registrant.

Township 25 Range 2W, W.M.
North

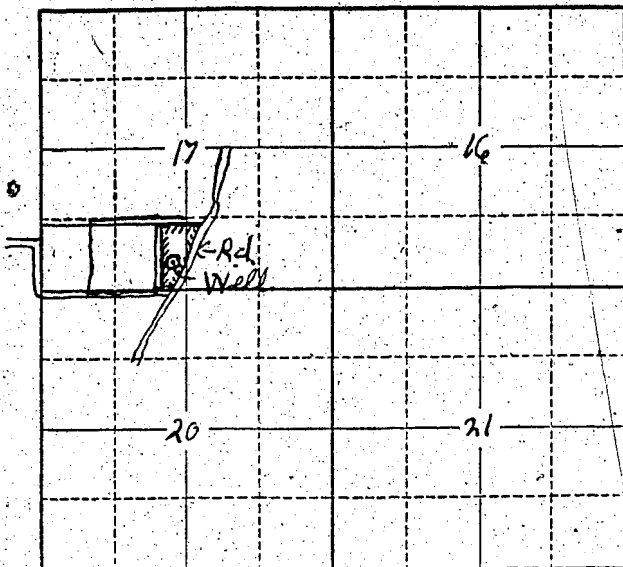

Locate well and acreage of irrigated land on plat.
Scale: 2" = 1 Mile

STATE OF OREGON

County of Marion } ss.

I, R.L. Freeberg, being first duly sworn, do hereby certify that I have read the foregoing Registration Statement and that all of the items therein contained are true to the best of my knowledge and belief.

R.L. Freeberg Gladys M. Freeberg
(Signature of Registrant)

Subscribed and sworn to before me this 24th day of March, 1958

My commission expires 12th June 1961 Wm. S. Bartholomew
(Notary Public)

(SEAL)

CERTIFICATE OF REGISTRATION

STATE OF OREGON } ss.
County of Marion

This is to certify that the foregoing Registration Statement was received in the office of the State Engineer on the 28th day of March, 1958, at 8:00 o'clock A.M. and has been duly recorded in said office in Book No. 6 of Registration Statements on page GR-1218

Witness my hand this 19 day of September, 1958

Lewis A. Stanley
(State Engineer)

By _____ (Deputy)