

RECEIVED  
MAR 24 1958  
STATE ENGINEER  
SALEM, OREGON

Registration No. GR. - 1292

Certificate No. GR. - 1249

# Registration Statement

## OF CLAIMANT OF RIGHT TO APPROPRIATE GROUND WATER

TO THE STATE ENGINEER OF OREGON:

I, Herald E & Margaret M. Goff

of Rt. 1 Box 278 Forest Grove County of Washington  
(Mailing address)

State of Oregon, do hereby make application for a certificate of registration as evidence of a right to appropriate ground water.

1. Source from which water is withdrawn is Flowing Well - Pumping Well  
(Flowing well, pump well, infiltration trench, or tunnel)
2. Location is: 2 1/2 mi. NW of Forest Grove  
(Approximate distance and direction from nearest city or town)

and is more particularly described as follows:

(a) 500' South & 125' West of NE Corner  
(Give distance and bearing to corner of section or other legal subdivision)

being within SE 1/4 of SE 1/4 of Sec. 23, Twp. 1 N, Rge. 4 W  
(Smallest legal subdivision) (N. or S.) (E. or W.)

or (b) within limits of recorded platted property, town or city:

in Lot \_\_\_\_\_, Block \_\_\_\_\_ of \_\_\_\_\_  
(Name of plat or addition)  
County of \_\_\_\_\_  
(If within city or town, give name)

3. Construction Work was begun on Aug 1950; was completed on Sept 1950  
(Date) (Date)

and the ground water claimed was first used for the purposes set out below on MAY 1951  
(Date)

since which time the water has been used Continuously or Intermittently - May - Sept  
(Continuously or Intermittently)

from 1951 to Oct 1957  
(Date) (Date)

4. Quantity of water claimed and used is 30 gallons per minute; 12 acre feet per year.

5. Purpose or Purposes for which water is used IRRIGATION

(Domestic, irrigation, municipal, manufacturing, industrial, etc.)

6. Description of Well: Depth 301 feet. Type drilled  
(Dug or drilled)

diameter 6 inches. Elevation of ground at well site 120 feet, mean sea level.  
(As near as known)

Depth to water table Flowing feet.

7. Capacity of Well: 24 g.p.m. with 61 feet drawdown.

30 g.p.m. with 107 feet drawdown.

36 g.p.m. with 166 feet drawdown.

Date of test Sept 11 - 1950

If Flowing Well: Measured discharge 8 g.p.m. on Sept 11 - 1950  
(Date)

Shut-in pressure at ground surface \_\_\_\_\_ lbs. per sq. in. on \_\_\_\_\_  
(Date)

Water is controlled by Flowing into a pond  
(Esp. valve, etc.)

8. Casing: (Give diameter, commercial specifications and depth below ground surface of each casing size.)

6 inch diameter from 0 to 168 feet  
 inch diameter from to feet  
 inch diameter from to feet  
 inch diameter from to feet

Describe and show depth of shoe, plug, adapter, liner or other details:

.....

.....

9. Perforated Casings or Screens:

1 - 1/2" x 20' from 148 to 168  
 (Number per foot and size of perforations, or describe screen)  
 from to  
 from to  
 from to

10. Log of Well: (Describe each stratum or formation clearly, indicate if water bearing, and give thickness and depth as indicated.)

MATERIAL	Thickness (Feet)	Depth to Bottom (Feet)
Soil	6	
Red clay		168
Rock		301

If log of well is not available, give name and address of driller. Frank Blair

11. Infiltration Trench: Covered or open \_\_\_\_\_

Dimensions: Length \_\_\_\_\_ ft. Minimum depth \_\_\_\_\_ ft. Maximum depth \_\_\_\_\_ ft.

Bottom width \_\_\_\_\_ ft. Discharge \_\_\_\_\_ g.p.m. Date of test \_\_\_\_\_

12. Tunnel: Type of lining \_\_\_\_\_

Dimensions: \_\_\_\_\_

(Length, course, and cross sectional size)

Position of water bearing stratum with reference to portal of tunnel \_\_\_\_\_

Log of tunnel: (Preceding table for log of well may be used, if desired. Give footage from portal and character of materials, as pertinent.)

13. Pumping Equipment:

(a) Pump IXT Watermaster Turbines Capacity 30 g.p.m.  
(Make, type and size)


(b) Motor 5HP Electric  
(Type and horsepower)

14. Location of area irrigated or to be irrigated, or place of use if for purposes other than irrigation.

Township North or South	Range E. or W. of Willamette Meridian	Section	Forty-acre Tract	Number Acres To Be Irrigated	Date of Reclamation
<u>1N</u>	<u>4W</u>	<u>23</u>	<u>SE 1/4 of SE 1/4</u>	<u>3.1</u>	<u>1951</u>
			<u>NE 1/4 SE 1/4</u>	<u>4.9</u>	
			<u>Total</u>	<u>8</u>	

15. If the ground water supply is supplemental to an existing water supply, identification of any application for a permit, permit, certificate or adjudicated right to appropriate water made or held by the registrant.

Township 1N Range 4W W.M.  
North

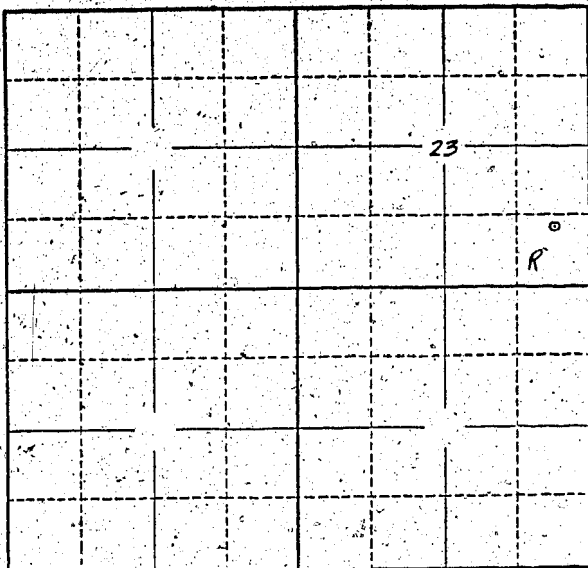

Locate well and acreage of irrigated land on plat.  
Scale: 2" = 1 Mile

STATE OF OREGON

County of Marion } ss.

I, Arnold E. Goff, being first duly sworn, do hereby certify that I have read the foregoing Registration Statement and that all of the items therein contained are true to the best of my knowledge and belief.

Arnold E. Goff  
(Signature of Registrant)

Subscribed and sworn to before me this 26th day of March, 1958

My commission expires 12th June 1961 Wm. S. Bartholomew  
(Notary Public)

(SEAL)

**CERTIFICATE OF REGISTRATION**

STATE OF OREGON } ss.  
County of Marion

This is to certify that the foregoing Registration Statement was received in the office of the State Engineer on the 28th day of March, 1958, at 8:00 o'clock A. M. and has been duly recorded in said office in Book No. 6 of Registration Statements on page GR-1219

Witness my hand this 19 day of September, 1958

Lewis A. Stanley  
(State Engineer)

By \_\_\_\_\_ (Deputy)