

# Registration Statement

## OF CLAIMANT OF RIGHT TO APPROPRIATE GROUND WATER

TO THE STATE ENGINEER OF OREGON:

I, LINDOW BROS.

of 3160 NW 143<sup>rd</sup> PORTLAND 1, ORE County of WASHINGTON

State of OREGON, do hereby make application for a certificate of registration as evidence of a right to appropriate ground water.

1. Source from which water is withdrawn is PUMP WELL - FLOW WELL  
(Flowing well, pump well, infiltration trench, or tunnel)

2. Location is: \_\_\_\_\_  
(Approximate distance and direction from nearest city or town)

and is more particularly described as follows:

(a) 1920'S W & 1250' E from NW corner Section 28  
(Give distance and bearing to corner of section or other legal subdivision)

being within SW 1/4 of NW 1/4 of Sec. 28, Twp. 1N, Rge. 1W  
(Smallest legal subdivision) (N. or S.) (E. or W.)

or (b) within limits of recorded platted property, town or city: \_\_\_\_\_

in Lot \_\_\_\_\_, Block \_\_\_\_\_ of \_\_\_\_\_  
(Name of plat or addition)

County of WASHINGTON  
(If within city or town, give name)

3. Construction Work was begun on Oct. 1951; was completed on April 1952  
(Date) (Date)

and the ground water claimed was first used for the purposes set out below on June 1952  
(Date)

since which time the water has been used Continuously during irrigation season  
(Continuously or intermittently)

from 1952 to 1958  
(Date) (Date)

4. Quantity of water claimed and used is 250 gallons per minute; \_\_\_\_\_ acre feet per year.

5. Purpose or Purposes for which water is used Domestic, livestock, Irrigation

(Domestic, irrigation, municipal, manufacturing, industrial, etc.)

6. Description of Well: Depth 580 feet. Type DRILLED  
(Dug or drilled)

diameter 12 inches. Elevation of ground at well site 208 feet, mean sea level.  
(As near as known)

Depth to water table 0 feet.

7. Capacity of Well: 250 g.p.m. with 250 feet drawdown.

\_\_\_\_\_ g.p.m. with \_\_\_\_\_ feet drawdown.

Date of test April 1952

If Flowing Well: Measured discharge 80 g.p.m. on April 1952  
(Date)

Shut-in pressure at ground surface 20 lbs. per sq. in. on April 1952  
(Date)

Water is controlled by Valve  
(Cap, valve, etc.)

8. Casing: (Give diameter, commercial specifications and depth below ground surface of each casing size.)

12 inch diameter from 0 to 480 feet  
 inch diameter Rock from 480 to 580 feet  
 inch diameter from to feet  
 inch diameter from to feet

Describe and show depth of shoe, plug, adapter, liner or other details:  
 Shoe on end of casing

9. Perforated Casings or Screens:

(Number per foot and size of perforations, or describe screen) from to  
 from to  
 from to  
 from to

10. Log of Well: (Describe each stratum or formation clearly, indicate if water bearing, and give thickness and depth as indicated.)

MATERIAL	Thickness (Feet)	Depth to Bottom (Feet)
Clay 0 - 480'	480'	
Basalt 480' - 580'	100'	
Artesian flow 80 gpm		

If log of well is not available, give name and address of driller. Strayen and Barron  
Beaumont, Oregon

11. Infiltration Trench: Covered or open .....  
 Dimensions: Length ..... ft. Minimum depth ..... ft. Maximum depth ..... ft.  
 Bottom width ..... ft. Discharge ..... g.p.m. Date of test .....

12. Tunnel: Type of lining .....  
 Dimensions: .....  
(Length, course, and cross sectional size)  
 Position of water bearing stratum with reference to portal of tunnel .....

Log of tunnel: (Preceding table for log of well may be used, if desired. Give footage from portal and character of materials, as pertinent.)


13. Pumping Equipment:  
 (a) Pump 17 stage turbine ..... Capacity 250 g.p.m.  
(Make, type and size)  
 (b) Motor 30 HP Electric Motor .....  
(Type and horsepower)

14. Location of area irrigated or to be irrigated, or place of use if for purposes other than irrigation.

Township North or South	Range E. or W. of Willamette Meridian	Section	Forty-acre Tract	Number Acres To Be Irrigated	Date of Reclamation
<u>1N</u>	<u>1W</u>	<u>28</u>	<u>SW 1/4 of NW 1/4</u>	<u>17.1</u>	<u>1952</u>
<u>1N</u>	<u>1W</u>	<u>28</u>	<u>SE 1/4 of NW 1/4</u>	<u>18.7</u>	<u>"</u>
<u>1N</u>	<u>1W</u>	<u>28</u>	<u>NW 1/4 of SW 1/4</u>	<u>8.4</u>	<u>"</u>
<u>1N</u>	<u>1W</u>	<u>28</u>	<u>NE 1/4 of SW 1/4</u>	<u>26.3</u>	<u>"</u>
<u>1N</u>	<u>1W</u>	<u>28</u>	<u>SW 1/4 of NE 1/4</u>	<u>0.8</u>	<u>"</u>
<u>1N</u>	<u>1W</u>	<u>28</u>	<u>NW 1/4 of SE 1/4</u>	<u>3.1</u>	<u>"</u>
				<u>74.4</u>	

15. If the ground water supply is supplemental to an existing water supply, identification of any application for a permit, permit, certificate or adjudicated right to appropriate water made or held by the registrant.  
None

Township 1N Range 1W, W.M.  
North

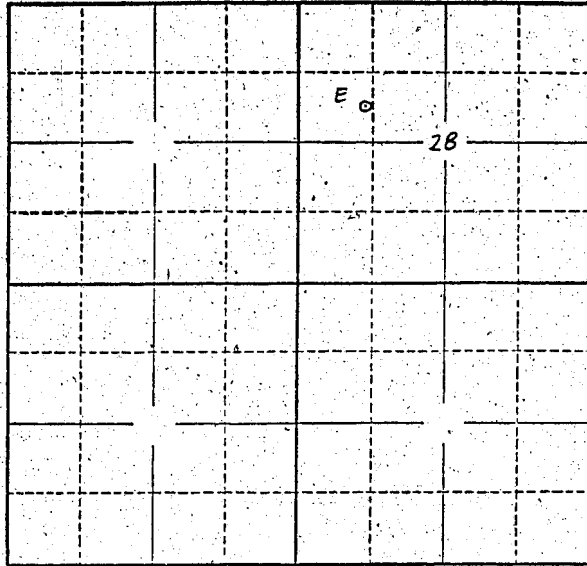

Locate well and acreage of irrigated land on plat.  
Scale: 2" = 1 Mile

STATE OF OREGON

County of Washington } ss.

I, A.W. Lindow & N.J. Lindow, being first duly sworn, do hereby certify that I have read the foregoing Registration Statement and that all of the items therein contained are true to the best of my knowledge and belief.

x A.W. Lindow  
x N.J. Lindow  
(Signature of Registrant)

Subscribed and sworn to before me this 26 day of March, 1958.

My commission expires 2-6-62 L.H. Vestmeyer  
(Notary Public)

(SEAL)

**CERTIFICATE OF REGISTRATION**

STATE OF OREGON

County of Marion } ss.

This is to certify that the foregoing Registration Statement was received in the office of the State Engineer on the 28th day of March, 1958, at E.C.C. o'clock ..... M. and has been duly recorded in said office in Book No. 6 of Registration Statements on page GR-1250

Witness my hand this 19 day of September, 1958

Lewis A. Stanley  
(State Engineer)

By \_\_\_\_\_  
(Deputy)