

Registration Statement

OF CLAIMANT OF RIGHT TO APPROPRIATE GROUND WATER

Serial 4 starting

TO THE STATE ENGINEER OF OREGON:

I, WILLY E. HEINRICH

of 20225 SW KINNAMON RD. ALOHA County of WASHINGTON
(Mailing address)

State of OREGON, do hereby make application for a certificate of registration as evidence of a right to appropriate ground water.

1. Source from which water is withdrawn is PUMP WELL #1
(Flowing well, pump well, infiltration trench, or tunnel)

2. Location is: 1 MILE WEST OF ALOHA OREGON
(Approximate distance and direction from nearest city or town)

and is more particularly described as follows:

(a) S 63° E 850 feet from NW corner Section 3
(Give distance and bearing to corner of section or other legal subdivision)

being within NW 1/4 & NW 1/4 of Sec. 3, Twp. 15, Rge. 2W
(Smallest legal subdivision) (N. or S.) (E. or W.)

or (b) within limits of recorded platted property, town or city:

in Lot _____, Block _____ of _____
(Name of plat or addition)

County of WASHINGTON
(If within city or town, give name)

3. Construction Work was begun on about 1918-20, was completed on about 1918-20
(Date) (Date)

and the ground water claimed was first used for the purposes set out below on about 1918-20,
(Date)

since which time the water has been used Continuously
(Continuously or intermittently)

from 1918-20 to 1958
(Date) (Date)

4. Quantity of water claimed and used is 8 gallons per minute; 2 1/2 acre feet per year.

5. Purpose or Purposes for which water is used Domestic and irrigation

(Domestic, irrigation, municipal, manufacturing, industrial, etc.)

6. Description of Well: Depth 100 feet. Type DRILLED
(Dug or drilled)

diameter 6 inches. Elevation of ground at well site 180 feet, mean sea level.
(As near as known)

Depth to water table 20 feet.

7. Capacity of Well: 8 g.p.m. with 60 feet drawdown.

_____ g.p.m. with _____ feet drawdown.


Date of test _____

If Flowing Well: Measured discharge _____ g.p.m. on _____
(Date)

Shut-in pressure at ground surface _____ lbs. per sq. in. on _____
(Date)

Water is controlled by _____
(Cap, valve, etc.)

Township 15 Range 2W, W.M.
North

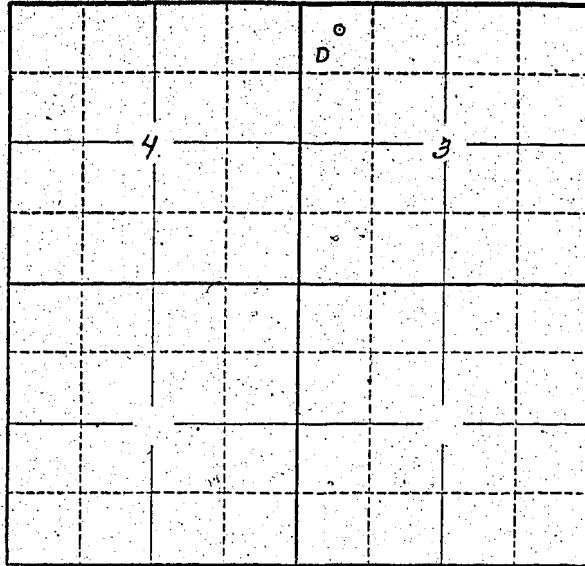

Locate well and acreage of irrigated land on plat.
Scale: 2" = 1 Mile

STATE OF OREGON }
County of Marion } ss.

I, _____, being first duly sworn, do hereby certify that I have read the foregoing Registration Statement and that all of the items therein contained are true to the best of my knowledge and belief.

Walter F. Heintz
(Signature of Registrant)

Subscribed and sworn to before me this 26th day of March, 1958

My commission expires 12th June 1961
Wm. S. Bartholomew
(Notary Public)

(SEAL)

CERTIFICATE OF REGISTRATION

STATE OF OREGON }
County of Marion } ss.

This is to certify that the foregoing Registration Statement was received in the office of the State Engineer on the 28th day of March, 1958, at 2:00 o'clock A. M. and has been duly recorded in said office in Book No. 6 of Registration Statements on page GR-1251

Witness my hand this 19 day of September, 1958

Lewis A. Stanley
(State Engineer)

By _____
(Deputy)