Registration No. GR – 11299

Certificate No. GR – 1256

Registration Statement

OF CLAIMANT OF RIGHT TO APPROPRIATE GROUND WATER

#1 Well

TO THE STATE ENGINEER OF OREGON:

I, Sisters of St Mary of Oregon,

of 4440 S.W. 148th Avenue Beaverton (Mailing address) County of Washington

State of Oregon, do hereby make application for a certificate of registration as evidence of a right to appropriate ground water.

1. **Source** from which water is withdrawn is Pump Well #1 (Flowing well, pump well, infiltration trench, or tunnel)

2. **Location** is: 1 mile West of Beaverton (Approximate distance and direction from nearest city or town);

and is more particularly described as follows:

(a) 1280' S 37° 30" W from NE Corner Sect 17 (Give distance and bearing to corner of section or other legal subdivision)

being within NE¼ of NE¼ (Smallest legal subdivision) of Sec. 17, Twp. 1 S (N. or S.), Rge. 1 W (E. or W.)

or (b) within limits of recorded platted property, town or city:

in Lot ....., Block ..... of ..... (Name of plat or addition)

..... (If within city or town, give name) County of .....

3. **Construction Work** was begun on 1935 (Date); was completed on 1935 (Date)

and the ground water claimed was first used for the purposes set out below on 1935 (Date),

since which time the water has been used Continuously (Continuously or intermittently)

from 1935 (Date) to 1957 (Date)

4. **Quantity** of water claimed and used is 30 gallons per minute; ..... acre feet per year.

5. **Purpose or Purposes** for which water is used Domestic & Irrigation

..... (Domestic, irrigation, municipal, manufacturing, industrial, etc.)

6. **Description of Well:** Depth 212 feet. Type drilled (Dug or drilled)

diameter 6 inches. Elevation of ground at well site 200 (As near as known) feet, mean sea level.

Depth to water table ..... feet.

7. **Capacity of Well:** 30 g.p.m. with 30 feet drawdown.

..... g.p.m. with ..... feet drawdown.

Date of test ?

If Flowing Well: Measured discharge ..... g.p.m. on ..... (Date)

Shut-in pressure at ground surface ..... lbs. per sq. in. on ..... (Date)

Water is controlled by ..... (Cap, valve, etc.)

8. **Casing:** (Give diameter, commercial specifications and depth below ground surface of each casing size.)

6" inch diameter unk. from ..... to ..... feet

..... inch diameter ..... from ..... to ..... feet

..... inch diameter ..... from ..... to ..... feet

..... inch diameter ..... from ..... to ..... feet

Describe and show depth of shoe, plug, adapter, liner or other details: .....

9. **Perforated Casings or Screens:**

unknown (Number per foot and size of perforations, or describe screen) from ..... to .....

..... from ..... to .....

..... from ..... to .....

..... from ..... to .....

10. **Log of Well:** (Describe each stratum or formation clearly, indicate if water bearing, and give thickness and depth as indicated.)

MATERIAL	Thickness (Feet)	Depth to Bottom (Feet)
unknown		

GR 1256

If log of well is not available, give name and address of driller. Unknown Alec Olson Gresham, Oregon

11. **Infiltration Trench:** Covered or open

Dimensions: Length ..... ft. Minimum depth ..... ft. Maximum depth ..... ft.

Bottom width ..... ft. Discharge ..... g.p.m. Date of test .....

12. **Tunnel:** Type of lining .....

Dimensions: .....
(Length, course, and cross sectional size)

Position of water bearing stratum with reference to portal of tunnel .....

Log of tunnel: (Preceding table for log of well may be used, if desired. Give footage from portal and character of materials, as pertinent.)

13. **Pumping Equipment:**

(a) Pump Deming deep well Turbine (Make, type and size) Capacity 30 g.p.m.

(b) Motor 5 HP 1 Φ Electric Motor (Type and horsepower)

14. Location of area irrigated or to be irrigated, or place of use if for purposes other than irrigation.

Township North or South	Range E. or W. of Willamette Meridian	Section	Forty-acre Tract	Number Acres To Be Irrigated	Date of Reclamation
1S	1W	17	NE/4 of NE/4	4.5 acres	1935

15. If the ground water supply is supplemental to an existing water supply, identification of any application for a permit, permit, certificate or adjudicated right to appropriate water made or held by the registrant.

.....

.....

Township 1S. Range 1W, W.M.

North

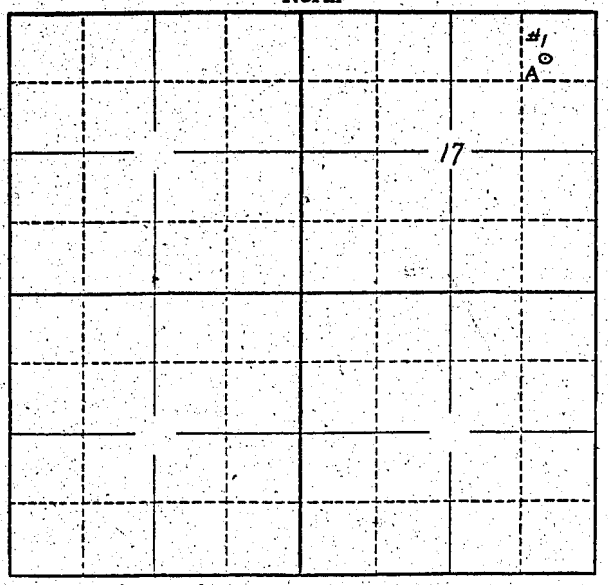

Locate well and acreage of irrigated land on plat.

Scale: 2" — 1 Mile

STATE OF OREGON
County of Marion } ss.

I, ..., being first duly sworn, do hereby certify that I have read the foregoing Registration Statement and that all of the items therein contained are true to the best of my knowledge and belief.

Lester of St Mary of Oregon
Lester Mary Christine
(Signature of Registrant)

Subscribed and sworn to before me this 26th day of March, 19 58

My commission expires 12th June 1961

Wm. S. Bartholomew
(Notary Public)

(SEAL)

CERTIFICATE OF REGISTRATION

STATE OF OREGON
County of Marion } ss.

This is to certify that the foregoing Registration Statement was received in the office of the State Engineer on the 31st day of March, 1958, at 8:00 o'clock A M. and has been duly recorded in said office in Book No. 6 of Registration Statements on page GR-1256

Witness my hand this 19 day of September 19 58.

Lewis A. Stanley
(State Engineer)

By .....
(Deputy)

GR-1256