

RECEIVED
1955

Registration Statement

OF CLAIMANT OF RIGHT TO APPROPRIATE GROUND WATER

(Under Chapter 708, Oregon Laws 1955.)

TO THE STATE ENGINEER OF OREGON:

1. Claude A. Raybourn

of Pt. 2 Box 68 Boring County of Clackamas

State of Oregon, do hereby make application for a certificate of registration as evidence of a right to appropriate ground water.

1. Source from which water is withdrawn is pump well
(Flowing well, pump well, infiltration trench, or tunnel)

2. Location is: 2 miles N-E Boring on Baldy Mt. road
(Approximate distance and direction from nearest city or town)

and is more particularly described as follows:

(a) 105 feet north and 342 feet east from SE corner of NE 1/4 of NE 1/4 section 31.
(Give distance and bearing to corner of section or other legal subdivision)

being within W 1/2 of the NE 1/4 of the NE 1/4 of Sec. 31, Twp. 1-S, Rge. 4-E
(Smallest legal subdivision) (N. or S.) (E. or W.)

or (b) within limits of recorded platted property, town or city:

in Lot 7, Block _____ of _____
(Name of plat or addition)

County of Clackamas
(If within city or town, give name)

3. Construction Work was begun on March 2, 1954; was completed on March 22, 1954
(Date) (Date)

and the ground water claimed was first used for the purposes set out below on July 1, 1954
(Date)

since which time the water has been used continuously
(Continuously or intermittently)

from July 1, 1954 to Nov. 1, 1955
(Date) (Date)

4. Quantity of water claimed and used is 3.0 gallons per minute; _____ acre feet per year.

5. Purpose or Purposes for which water is used Domestic, irrigation

(Domestic, irrigation, municipal, manufacturing, industrial, etc.)

6. Description of Well: Depth 157 feet. Type drilled
(Dug or drilled)

diameter 8 inches. Elevation of ground at well site 562 feet, mean sea level.
(As high as known)

Depth to water table 3.0 feet.

7. Capacity of Well: 10 g.p.m. with 5.0 feet drawdown.

_____ g.p.m. with _____ feet drawdown.


Date of test Nov. 4, 1954

If Flowing Well: Measured discharge _____ g.p.m. on _____
(Date)

Shut-in pressure at ground surface _____ lbs. per sq. in. on _____
(Date)

Water is controlled by _____
(Cap, valve, etc.)

Township 1-S Range 4-E W.M.
North

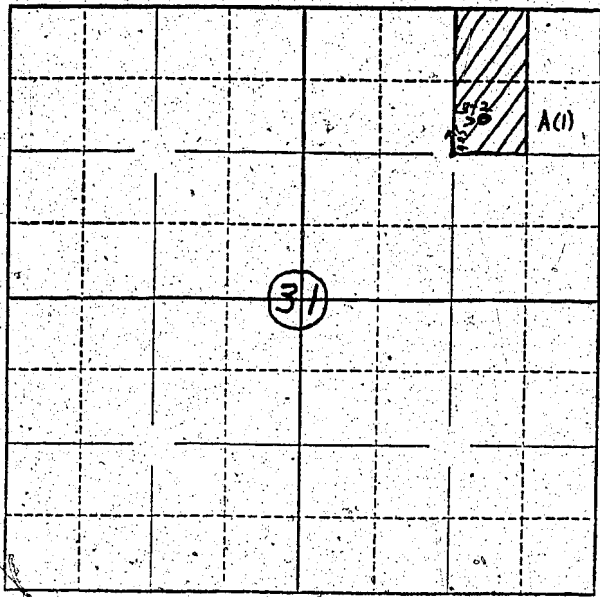

Locate well and acreage of irrigated land on plat.

Scale: * = 1 Mile

STATE OF OREGON

County of Washington } ss.

I, Claud A. Robinson being first duly sworn, do hereby certify that I have read the foregoing Registration Statement and that all of the items therein contained are true to the best of my knowledge and belief.

Claud A. Robinson
(Signature of Registrant)

Subscribed and sworn to before me this 2nd day of December 19 55

My commission expires 8/6/58

Mary Ann McCreary
(Notary Public)

(SEAL)

CERTIFICATE OF REGISTRATION

STATE OF OREGON } ss.

County of Marion

This is to certify that the foregoing Registration Statement was received in the office of the State Engineer on the 28th day of February, 19 56, at 10:00 o'clock A. M. and has been duly recorded in said office in Book No. 1 of Registration Statements on page GR-121C.

~~Construction shall be completed by _____ and the water accepted for beneficial use by _____~~

Witness my hand this 12th day of April, 19 56

Lewis A. Stanley
(State Engineer)

By _____
(Deputy)