

# Registration Statement

## OF CLAIMANT OF RIGHT TO APPROPRIATE GROUND WATER

#2 Well

TO THE STATE ENGINEER OF OREGON:

I, Sisters of St Mary of Oregon

of 4440 SW 148<sup>th</sup> Ave Beaverton County of Washington

(Mailing address)

State of Oregon, do hereby make application for a certificate of registration as evidence of a right to appropriate ground water.

1. Source from which water is withdrawn is Pump well  
(Flowing well, pump well, infiltration trench, or tunnel)

2. Location is: 1 mile West of Beaverton  
(Approximate distance and direction from nearest city or town)

and is more particularly described as follows:

(a) 970' S. 70° W. of NE Corner of Sect. 17  
(Give distance and bearing to corner of section or other legal subdivision)

being within NE 1/4 of NE 1/4 of Sec. 17, Twp. 15, Rge. 1 W.  
(Smallest legal subdivision) (N. or S.) (E. or W.)

or (b) within limits of recorded platted property, town or city:

in Lot \_\_\_\_\_, Block \_\_\_\_\_ of \_\_\_\_\_  
(Name of plat or addition)

County of \_\_\_\_\_  
(If within city or town, give name)

3. Construction Work was begun on May 1954; was completed on May 1954  
(Date) (Date)

and the ground water claimed was first used for the purposes set out below on June 1954  
(Date)

since which time the water has been used Continuously  
(Continuously or intermittently)

from 1954 to 1957  
(Date) (Date)

4. Quantity of water claimed and used is 30 gallons per minute; \_\_\_\_\_ acre feet per year.

5. Purpose or Purposes for which water is used Domestic & Irrigation

(Domestic, irrigation, municipal, manufacturing, industrial, etc.)

6. Description of Well: Depth 215 feet. Type drilled  
(Dug or drilled)

diameter 8" inches. Elevation of ground at well site 200 feet, mean sea level.  
(As near as known)

Depth to water table 52 feet.

7. Capacity of Well: 45 g.p.m. with 195 feet drawdown.

30 g.p.m. with 195 feet drawdown.

Date of test 1941 1954  
Feb. 1958

If Flowing Well: Measured discharge \_\_\_\_\_ g.p.m. on \_\_\_\_\_  
(Date)


Shut-in pressure at ground surface \_\_\_\_\_ lbs. per sq. in. on \_\_\_\_\_  
(Date)

Water is controlled by \_\_\_\_\_  
(Cap, valve, etc.)





Township 1S Range 1W, W.M.  
North

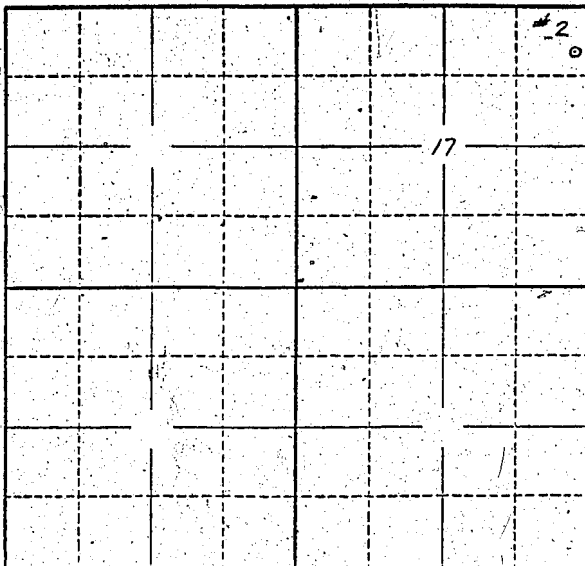

Locate well and acreage of irrigated land on plat.  
Scale: 2" = 1 Mile

STATE OF OREGON

County of Marion

} ss.

I, \_\_\_\_\_, being first duly sworn, do hereby certify that I have read the foregoing Registration Statement and that all of the items therein contained are true to the best of my knowledge and belief.

Secretary of St. Mary of Oregon  
St. Mary  
(Signature of Registrant)

Subscribed and sworn to before me this 26th day of March, 1958.

My commission expires 12th June 1961

Wm. J. Bartholomew  
(Notary Public)

(SEAL)

**CERTIFICATE OF REGISTRATION**

STATE OF OREGON

County of Marion

} ss.

This is to certify that the foregoing Registration Statement was received in the office of the State Engineer on the 31st day of March, 1958, at 8:00 o'clock A. M. and has been duly recorded in said office in Book No. 6 of Registration Statements on page GR-1257

Witness my hand this 19 day of September, 1958

Lewis A. Stanley  
(State Engineer)

By \_\_\_\_\_

(Deputy)