

# Registration Statement

## OF CLAIMANT OF RIGHT TO APPROPRIATE GROUND WATER

\* 4 Well

TO THE STATE ENGINEER OF OREGON:

I, Sisters of St Mary of Oregon  
of 4440 SW 148<sup>th</sup> Ave Beaverton County of Washington  
(Mailing address)

State of Oregon do hereby make application for a certificate of registration as evidence of a right to appropriate ground water.

1. Source from which water is withdrawn is Pump well #11  
(Flowing well, pump well, infiltration trench, or tunnel)

2. Location is: 1 mile west of Beaverton  
(Approximate distance and direction from nearest city or town)

and is more particularly described as follows:

(a) 1400' S 12° 0' W of NE Corner Sec 17  
(Give distance and bearing to corner of section or other legal subdivision)

being within SE 1/4 of NE 1/4 of Sec. 17, Twp. 15 Rge. 10  
(Smallest legal subdivision) (N. or S.) (E. or W.)

or (b) within limits of recorded platted property, town or city:

in Lot \_\_\_\_\_ Block \_\_\_\_\_ of \_\_\_\_\_  
(Name of plat or addition)

County of \_\_\_\_\_  
(If within city or town, give name)

3. Construction Work was begun on 1935?; was completed on 1935  
(Date) (Date)

and the ground water claimed was first used for the purposes set out below on 1935  
(Date)

since which time the water has been used Continuously  
(Continuously or intermittently)

from 1935 to \_\_\_\_\_  
(Date) (Date)

4. Quantity of water claimed and used is 50 gallons per minute; \_\_\_\_\_ acre feet per year.

5. Purpose or Purposes for which water is used Domestic & Irrigation  
(Domestic, irrigation, municipal, manufacturing, industrial, etc.)

6. Description of Well: Depth 210 feet. Type drilled  
(Dug or drilled)

diameter 6" inches. Elevation of ground at well site \_\_\_\_\_ feet, mean sea level.  
(As near as known)

Depth to water table 90 feet.

7. Capacity of Well: 50 g.p.m. with 160' feet drawdown.

\_\_\_\_\_ g.p.m. with \_\_\_\_\_ feet drawdown.

Date of test Feb 1958

If Flowing Well: Measured discharge \_\_\_\_\_ g.p.m. on \_\_\_\_\_  
(Date)

Shut-in pressure at ground surface \_\_\_\_\_ lbs. per sq. in. on \_\_\_\_\_  
(Date)

Water is controlled by \_\_\_\_\_  
(Cap. valve, etc.)

8. Casing: (Give diameter, commercial specifications and depth below ground surface of each casing size.)

6" inch diameter ..... from 2 to 2.2 feet  
 ..... inch diameter ..... from ..... to ..... feet  
 ..... inch diameter ..... from ..... to ..... feet  
 ..... inch diameter ..... from ..... to ..... feet

Describe and show depth of shoe, plug, adapter, liner or other details: .....

9. Perforated Casings or Screens:

..... from ..... to .....  
(Number per foot and size of perforations, or describe screen)  
 ..... from ..... to .....  
 ..... from ..... to .....  
 ..... from ..... to .....

10. Log of Well: (Describe each stratum or formation clearly, indicate if water bearing, and give thickness and depth as indicated.)

MATERIAL	Thickness (Feet)	Depth to Bottom (Feet)
<i>Not known but should be similar to well # 2</i>		

If log of well is not available, give name and address of driller. Alie Olson, Heston

11. Infiltration Trench: Covered or open \_\_\_\_\_  
Dimensions: Length \_\_\_\_\_ ft. Minimum depth \_\_\_\_\_ ft. Maximum depth \_\_\_\_\_ ft.  
Bottom width \_\_\_\_\_ ft. Discharge \_\_\_\_\_ g.p.m. Date of test \_\_\_\_\_
12. Tunnel: Type of lining \_\_\_\_\_  
Dimensions: \_\_\_\_\_  
(Length, course, and cross sectional size)  
Position of water bearing stratum with reference to portal of tunnel \_\_\_\_\_

Log of tunnel: (Preceding table for log of well may be used, if desired. Give footage from portal and character of materials, as pertinent.)


13. Pumping Equipment:  
(a) Pump Denney Deep Well Turbine Capacity 50 g.p.m.  
(Make, type and size)  
(b) Motor 5 HP 30 Electric  
(Type and horsepower)

14. Location of area irrigated or to be irrigated, or place of use if for purposes other than irrigation.

Township North or South	Range E. or W. of Williamsite Meridian	Section	Forty-acre Tract	Number Acres To Be Irrigated	Date of Reclamation
<u>15</u>	<u>1 W</u>	<u>17</u>	<u>SE 1/4 of NE 1/4</u>	<u>42 in conjunction with well #1 &amp; #2</u>	

15. If the ground water supply is supplemental to an existing water supply, identification of any application for a permit, permit, certificate or adjudicated right to appropriate water made or filed by the registrant.

Township 15 Range 1W, W.M.  
North

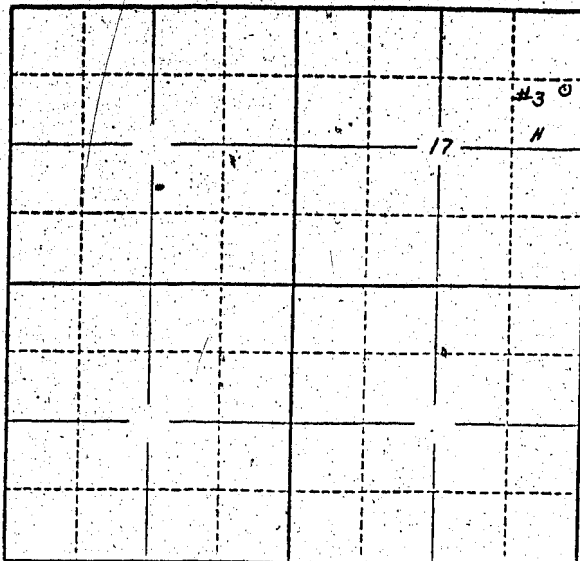

Locate well and acreage of irrigated land on plat.

Scale: 2" = 1 Mile

STATE OF OREGON

County of Marion

ss.

I, \_\_\_\_\_, being first duly sworn, do hereby certify that I have read the foregoing Registration Statement and that all of the items therein contained are true to the best of my knowledge and belief.

Sister of St. Mary of Oregon

Sister Mary Christina  
(Signature of Registrant)

Subscribed and sworn to before me this 26th day of March, 1958.

My commission expires 12th June 1961

Wm. S. Bartholomew  
(Notary Public)

(SEAL)

### CERTIFICATE OF REGISTRATION

STATE OF OREGON

County of Marion

ss.

This is to certify that the foregoing Registration Statement was received in the office of the State Engineer on the 31 day of March, 1958, at 800 o'clock A. M. and has been duly recorded in said office in Book No. 6 of Registration Statements on page GR-1258

Witness my hand this 19 day of September, 1958

Lewis A. Stanley  
(State Engineer)

By \_\_\_\_\_

(Deputy)

GR - 1258