

### Registration Statement

#### OF CLAIMANT OF RIGHT TO APPROPRIATE GROUND WATER

(Under Chapter 706, Oregon Laws 1955.)

TO THE STATE ENGINEER OF OREGON:

I, Carl T. Morris

of Route 1, Box 96, Jefferson County of Marion

State of Oregon, do hereby make application for a certificate of registration as evidence of a right to appropriate ground water.

1. Source from which water is withdrawn is Pump well #1  
(Flowing well, pump well, infiltration trench, or tunnel)

2. Location is: Eight miles North west of Jefferson  
(Approximate distance and direction from nearest city or town)

and is more particularly described as follows:

(a) 1200 feet west and 2250 feet north from SE corner Section 13-  
(Give distance and bearing to corner of section or other legal subdivision)

being within NE 1/4 & SE 1/4 of Sec. 13, Twp. 9S, Rge. 4W  
(Smallest legal subdivision) (N. or S.) (E. or W.)

or (b) within limits of recorded platted property, town or city: 0

in Lot \_\_\_\_\_ Block \_\_\_\_\_ of \_\_\_\_\_  
(Name of plat or addition)

County of Marion  
(If within city or town, give name)

3. Construction Work was begun on April 1943; was completed on April 1943  
(Date) (Date)

and the ground water claimed was first used for the purposes set out below on June 1944  
(Date)

since which time the water has been used continuously  
(Continuously or intermittently)

from June 1944 to Oct 1957  
(Date) (Date)

4. Quantity of water claimed and used is 560 g. gallons per minute; 125 acre foot per year.

5. Purpose or Purposes for which water is used: irrigation  
(Domestic, irrigation, municipal, manufacturing, industrial, etc.)

6. Description of Well: Depth 33-16' feet. Type drilled  
(Dug or drilled)

diameter 12 inches. Elevation of ground at well site \_\_\_\_\_ feet, mean sea level.  
(As near as known)

Depth to water table 12 feet.

7. Capacity of Well: 600 g.p.m. with 12 feet drawdown.

\_\_\_\_\_ g.p.m. with \_\_\_\_\_ feet drawdown.

Date of test \_\_\_\_\_

If Flowing Well: Measured discharge \_\_\_\_\_ g.p.m. on \_\_\_\_\_  
(Date)

Shut-in pressure at ground surface \_\_\_\_\_ lbs. per sq. in. on \_\_\_\_\_  
(Date)

Water is controlled by \_\_\_\_\_  
(Cap, valve, etc.)

8. Casing: (Give diameter, commercial specifications and depth below ground surface of each casing size.)

10 inch diameter *Unknown* from *8* to *33.10* feet  
inch diameter from to feet  
inch diameter from to feet  
inch diameter from to feet

Describe and show depth of shoe, plug, adapter, liner or other details:

9. Perforated Casings or Screens:

*2 per ft. 1" x 8"* from *2.3* to *3.5*  
(Number per foot and size of perforations, or describe screen)  
from to  
from to  
from to

10. Log of Well: (Describe each stratum or formation clearly, indicate if water bearing, and give thickness and depth as indicated.)

MATERIAL	Thickness (Feet)	Depth to Bottom (Feet)
<i>Unknown</i>		

If log of well is not available, give name and address of driller. Recessed

11. Infiltration Trench: Covered or open no  
 Dimensions: Length \_\_\_\_\_ ft. Minimum depth \_\_\_\_\_ ft. Maximum depth \_\_\_\_\_ ft.  
 Bottom width \_\_\_\_\_ ft. Discharge \_\_\_\_\_ g.p.m. Date of test \_\_\_\_\_

12. Tunnel: Type of lining cu  
 Dimensions: \_\_\_\_\_  
(Length, course, and cross sectional size)  
 Position of water bearing stratum with reference to portal of tunnel \_\_\_\_\_

Log of tunnel: (Preceding table for log of well may be used, if desired. Give footage from portal and character of materials, as pertinent.)


13. Pumping Equipment:  
 (a) Pump Cornell - centrifugal Capacity 575 g.p.m.  
(Make, type and size)  
 (b) Motor 20 HP 36  
(Type and horsepower)

14. Location of area irrigated or to be irrigated, or place of use if for purposes other than irrigation.

Township North or South	Range E. or W. of Willamette Meridian	Section	Forty-acre Tract	Number Acres To Be Irrigated	Date of Reclamation
T9S	R3W	18	SW <sup>1</sup> / <sub>4</sub> of SW <sup>1</sup> / <sub>4</sub>	5 <sup>0</sup>	June 1944
"	"	18	NW <sup>1</sup> / <sub>4</sub> of SW <sup>1</sup> / <sub>4</sub>	15	" "
T9S	R4W	13	NE <sup>1</sup> / <sub>4</sub> of SE <sup>1</sup> / <sub>4</sub>	35 <sup>0</sup>	" "
"	"	13	NW <sup>1</sup> / <sub>4</sub> of SE <sup>1</sup> / <sub>4</sub>	0.32	" "
"	"	13	SE <sup>1</sup> / <sub>4</sub> of SE <sup>1</sup> / <sub>4</sub>	10.2	1950
				<u>51.82</u>	

15. If the ground water supply is supplemental to an existing water supply, identification of any application for a permit, permit, certificate or adjudicated right to appropriate water made or held by the registrant.

Township 9S Range 4W, W.M.  
North

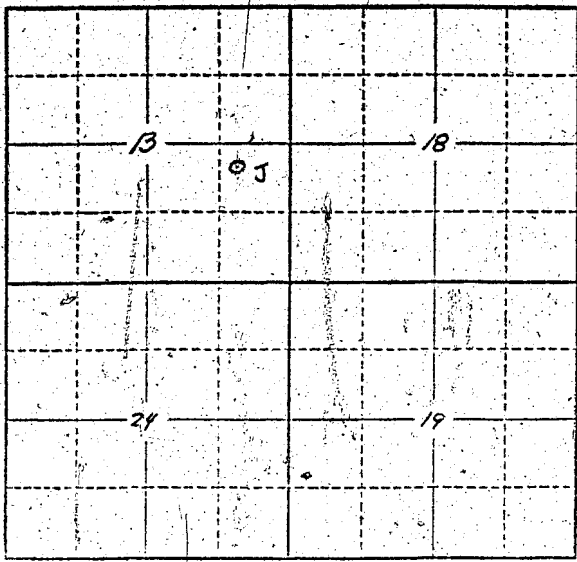

Locate well and acreage of irrigated land on plat.  
Scale: 2" = 1 Mile

STATE OF OREGON }  
County of Marion } ss.

I, \_\_\_\_\_, being first duly sworn, do hereby certify that I have read the foregoing Registration Statement and that all of the items therein contained are true to the best of my knowledge and belief.

Carl T. Morris  
(Signature of Registrant)

Subscribed and sworn to before me this 31st day of March, 1958

My commission expires 12th June 1961  
Wm. S. Bartholomew  
(Notary Public)

(SEAL)

**CERTIFICATE OF REGISTRATION**

STATE OF OREGON }  
County of Marion } ss.

This is to certify that the foregoing Registration Statement was received in the office of the State Engineer on the 31 day of March, 1958, at 2:30 o'clock P. M. and has been duly recorded in said office in Book No. 6 of Registration Statements on page GR-1259

~~Construction shall be completed by \_\_\_\_\_, 19\_\_\_\_, and the water completed by \_\_\_\_\_  
and the fee by \_\_\_\_\_, 19\_\_\_\_.~~

Witness my hand this 20th day of October, 1958.

Lewis A. Stansen  
(State Engineer)

By \_\_\_\_\_  
(Deputy)

GR-1259