

Registration Statement

OF CLAIMANT OF RIGHT TO APPROPRIATE GROUND WATER

TO THE STATE ENGINEER OF OREGON:

I, Don E. Buckley

of Star Route, Box 40, St. Paul County of Marion
(Mailing address)

State of Oregon do hereby make application for a certificate of registration as evidence of a right to appropriate ground water.

1. Source from which water is withdrawn is Pump well
(Flowing well, pump well, infiltration trench, or tunnel)

2. Location is: approximately 3350' due west of St. Paul
(Approximate distance and direction from nearest city or town)

and is more particularly described as follows:

(a) 780' south & 959' west of S.E. corner M. Accotti D.L.C. #73
(Give distance and bearing to corner of section or other legal subdivision)

being within S&W of NW of Sec. 19, Twp. 4S, Rge. 2W
(Smallest legal subdivision) (N. or S.) (E. or W.)

or (b) within limits of recorded platted property, town or city:

in Lot _____ Block _____ of _____
(Name of plat or addition)

County of _____
(If within city or town, give name)

3. Construction Work was begun on October 1949; was completed on October 1949.
(Date) (Date)

and the ground water claimed was first used for the purposes set out below on June 1, 1950
(Date)

since which time the water has been used continuously - summer irrigation
(Continuously or intermittently)

from June 1950 to March 1958
(Date) (Date)

4. Quantity of water claimed and used is 192 gallons per minute; _____ acre feet per year.

5. Purpose or Purposes for which water is used irrigation

(Domestic, irrigation, municipal, manufacturing, industrial, etc.)

6. Description of Well: Depth 129 feet. Type drilled

(Dug or drilled)

diameter 8 inches. Elevation of ground at well site 169 feet, mean sea level.
(As near as known)

Depth to water table 42 feet.

7. Capacity of Well: 250 g.p.m. with 51 feet drawdown.

_____ g.p.m. with _____ feet drawdown.

Date of test October 1949

If Flowing Well: Measured discharge _____ g.p.m. on _____

(Date)

Shut-in pressure at ground surface _____ lbs. per sq. in. on _____

(Date)

Water is controlled by _____

(Cap, valve, etc.)

8. Casing: (Give diameter, commercial specifications and depth below ground surface of each casing size.)

8 inch diameter from 0 to 121 feet
 inch diameter from to feet
 inch diameter from to feet
 inch diameter from to feet

Describe and show depth of shoe, plug, adapter, liner or other details:

9. Perforated Casings or Screens:

..... from to
(Number per foot and size of perforations, or describe screen)
 from to
 from to
 from to

10. Log of Well: (Describe each stratum or formation clearly, indicate if water bearing, and give thickness and depth as indicated.)

MATERIAL	Thickness (Feet)	Depth to Bottom (Feet)
surface soil	5	5
yellow surface clay	30	35
surface soil - some water	9	44
sandy clay - grey	42	86
blue clay	12	98
blue sandy clay	6	104
grey clay	17	121
blue clay	3	124
coarse black sand & small gravel	5	129

If log of well is not available, give name and address of driller: _____

11. Infiltration Trench: Covered or open _____

Dimensions: Length _____ ft. Minimum depth _____ ft. Maximum depth _____ ft.

Bottom width _____ ft. Discharge _____ g.p.m. Date of test _____

12. Tunnel: Type of lining _____

Dimensions: _____
(Length, course, and cross sectional size)

Position of water bearing stratum with reference to portal of tunnel _____

Log of tunnel: (Preceding table for log of well may be used, if desired. Give footage from portal and character of materials, as pertinent.)

13. Pumping Equipment:

(a) Pump _____ Peerless line shaft turbine _____ Capacity _____ 220 _____ g.p.m.
(Make, type and size)

(b) Motor _____ Electric - 10 HP three phase - 240 volt _____
(Type and horsepower)


14. Location of area irrigated or to be irrigated, or place of use if for purposes other than irrigation.

Township North or South	Range E. or W. of Willamette Meridian	Section	Forty-acre Tract	Number Acres To Be Irrigated	Date of Reclamation
4S	2W	19	NW $\frac{1}{4}$ of NW $\frac{1}{4}$	5.7	June 1, 1950
			SW $\frac{1}{4}$ of NW $\frac{1}{4}$	37.4	June 1, 1950
			SE $\frac{1}{4}$ of NW $\frac{1}{4}$	3.4	June 1, 1950
			NW $\frac{1}{4}$ of SW $\frac{1}{4}$	12.4	June 1, 1950
			NE $\frac{1}{4}$ of NW $\frac{1}{4}$.6	June 1, 1950
4S	3W	24	NE $\frac{1}{4}$ of NE $\frac{1}{4}$.6	June 1, 1950
			SE $\frac{1}{4}$ of NE $\frac{1}{4}$	5.8	June 1, 1950
			NE $\frac{1}{4}$ of SE $\frac{1}{4}$	2.1	June 1, 1950
				68.0	

15. If the ground water supply is supplemental to an existing water supply, identification of any application for a permit, permit, certificate or adjudicated right to appropriate water made or held by the registrant:

Township _____ Range _____ W.M.

T49R3W North T49R2W

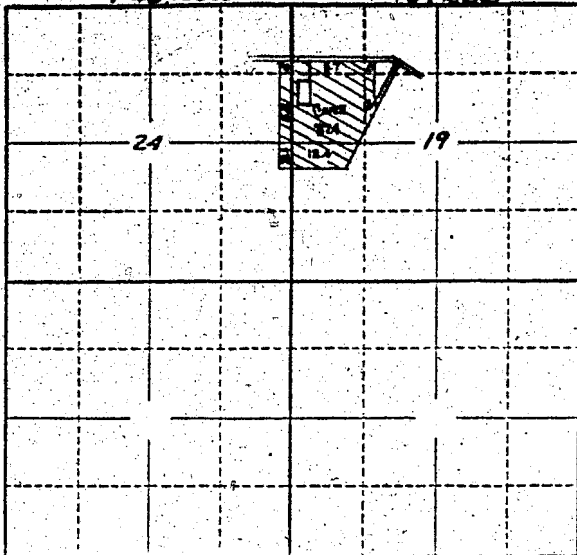

Locate well and acreage of irrigated land on plat.

Scale: 2" = 1 Mile

STATE OF OREGON

County of Marion } ss.

I, Leon E. Buckley, being first duly sworn, do hereby certify that I have read the foregoing Registration Statement and that all of the items therein contained are true to the best of my knowledge and belief.

Leon E. Buckley
(Signature of Registrant)

Subscribed and sworn to before me this 1st day of April, 1958

My commission expires Mar 11 1959

C. N. Davis
(Notary Public)

(SEAL)

CERTIFICATE OF REGISTRATION

STATE OF OREGON

County of Marion } ss.

This is to certify that the foregoing Registration Statement was received in the office of the State Engineer on the 1st day of April, 1958, at 8⁰⁰ o'clock A. M. and has been duly recorded in said office in Book No. 61 of Registration Statements on page GR-1265

Witness my hand this 20th day of October, 1958

Lewis A. Stanley
(State Engineer)

By _____ (Deputy)