

RECEIVED

FEB 23 1956

STATE ENGINEER
SALEM, OREGON

Registration Statement

REGISTRATION NO. GR-131

CERTIFICATE NO. GR-122

OF CLAIMANT OF RIGHT TO APPROPRIATE GROUND WATER

(Under Chapter 708, Oregon Laws 1955.)

TO THE STATE ENGINEER OF OREGON:

I, Walter H and Hazel Pearl Engler
of Tigard County of Washington

State of Oregon, do hereby make application for a certificate of registration as evidence of a right to appropriate ground water.

1. Source from which water is withdrawn is Pump Well
(Flowing well, pump well, infiltration trench, or tunnel)

2. Location is: Approx. two miles S.W. of Tigard
(Approximate distance and direction from nearest city or town)

and is more particularly described as follows:

(a) approx 392 North 459 E to corner Marquette Vels tract
(Give distance and bearing to corner of section or other legal subdivision)

being within RW 1/4 SW 1/4 of Sec. 11, Twp. T.25, Rge. R.1W, W.M
(Smallest legal subdivision) (N. or S.) (E. or W.)

or (b) within limits of recorded platted property, town or city: Tigard

in Lot 3, Block _____ of Marquette Vels Tract
(Name of plat or addition)
Tigard County of Washington
(If within city or town, give name)

3. Construction Work was begun on about Feb 15-53, was completed on Apr 10-1953
(Date) (Date)

and the ground water claimed was first used for the purposes set out below on approx May 1, 1953
(Date)

since which time the water has been used continuously for house, irrigation
(Continuously or intermittently)

from Apr to Oct
(Date) (Date)

4. Quantity of water claimed and used is approx 35 gallons per minute, approx 3.5 acre feet per year.

5. Purpose or Purposes for which water is used Domestic and to irrigate garden and yard approx April thru Oct
(Domestic, irrigation, municipal, manufacturing, industrial, etc.)

6. Description of Well: Depth 262 feet. Type drilled
(Dug or drilled)

diameter 6 inches. Elevation of ground at well site 300' feet, mean sea level.
(As near as known)

Depth to water table 100 when drilled feet.

7. Capacity of Well: approx 3.5 g.p.m. with 0 feet drawdown.

Unknown g.p.m. with _____ feet drawdown.


Date of test unknown 7/1953

If Flowing Well: Measured discharge NA g.p.m. on _____ (Date)

Shut-in pressure at ground surface NA lbs. per sq. in. on _____ (Date)

Water is controlled by NA
(Cap, valve, etc.)

Township 2S Range R1W W.M.
North

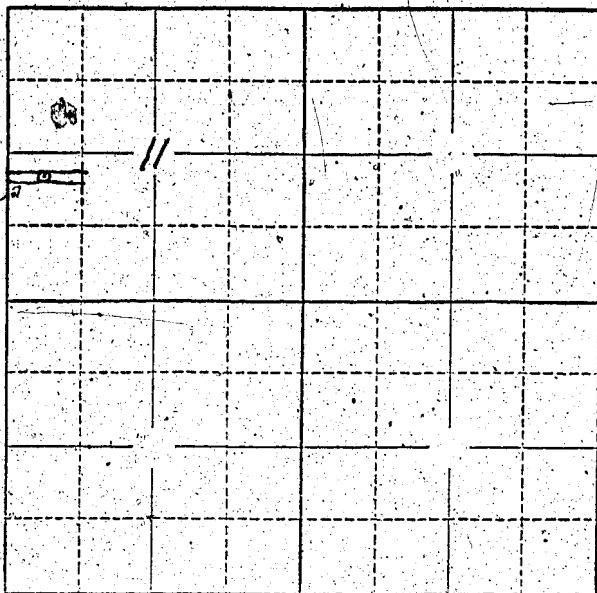

Locate well and acreage of irrigated land on plat.

Scale: 2" = 1 Mile

STATE OF OREGON

County of Washington } ss.

I, Walter H. Engler, being first duly sworn, do hereby certify that I have read the foregoing Registration Statement and that all of the items therein contained are true to the best of my knowledge and belief.

Walter H. Engler
Walter H. Engler
(Signature of Registrant)

Subscribed and sworn to before me this 20 day of _____, 19____.

My commission expires _____

June M. Benton
(Notary Public)

(SEAL)

CERTIFICATE OF REGISTRATION

STATE OF OREGON

County of Marion } ss.

This is to certify that the foregoing Registration Statement was received in the office of the State Engineer on the 23rd day of February, 1956, at 8:00 o'clock A. M. and has been duly recorded in said office in Book No. 1 of Registration Statements on page GR-122C

~~Construction to be completed by _____ 19____ and the owner completely supplied~~

~~benefited by _____ 19____~~

Witness my hand this 12th day of April, 1956.

Lewis A. Stanley
(State Engineer)

By _____ (Deputy)