

#15-00  
STATE ENGINEER  
SALEM, OREGON

Registration No. GR - 1310  
Certificate No. GR - 1267

# Registration Statement

## OF CLAIMANT OF RIGHT TO APPROPRIATE GROUND WATER

TO THE STATE ENGINEER OF OREGON:

I, BENNY ~~AND~~ McFore  
of Mc 3 Box 304 Milton Freewater Ore County of Umatilla  
(Mailing address)  
State of Oregon, do hereby make application for a certificate of registration as evidence  
of a right to appropriate ground water.

1. Source from which water is withdrawn is PUMP well  
(Flowing well, pump well, infiltration trench, or tunnel)  
2. Location is: 3 miles Northwest Milton Freewater  
(Approximate distance and direction from nearest city or town)

and is more particularly described as follows:

(a) 670 ft East & 825 ft South of NW Corner  
(Give distance and bearing to corner of section or other legal subdivision)  
being within NW 1/4 of SE 1/4 of Sec. 27 Twp. 6N Rge. 35 E  
(Smallest legal subdivision) (N. or S.) (E. or W.)  
or (b) within limits of recorded platted property, town or city: \_\_\_\_\_

in Lot \_\_\_\_\_, Block \_\_\_\_\_ of \_\_\_\_\_  
(Name of plat or addition)  
County of \_\_\_\_\_  
(If within city or town, give name)

3. Construction Work was begun on 1922; was completed on 1922  
(Date) (Date)

and the ground water claimed was first used for the purposes set out below on 1922  
(Date)  
since which time the water has been used continuously  
(Continuously or (Intermittently))  
from 1922 to 1957  
(Date) (Date)

4. Quantity of water claimed and used is 125 gallons per minute; 50 acre  
feet per year.

5. Purpose or Purposes for which water is used irrigation

(Domestic, irrigation, municipal, manufacturing, industrial, etc.)

6. Description of Well: Depth 34 feet. Type Dug  
(Dug or drilled)  
diameter 12 X 12 inches. Elevation of ground at well site 850  
(As near as known) feet, mean sea level.  
Depth to water table 23 feet.

7. Capacity of Well: 125 g.p.m. with 2 feet drawdown.  
\_\_\_\_\_ g.p.m. with \_\_\_\_\_ feet drawdown.

Date of test \_\_\_\_\_  
If Flowing Well: Measured discharge \_\_\_\_\_ g.p.m. on \_\_\_\_\_  
(Date)  
Shut-in pressure at ground surface \_\_\_\_\_ lbs. per sq. in. on \_\_\_\_\_  
(Date)  
Water is controlled by \_\_\_\_\_  
(Cap, valve, etc.)

8. Casing: (Give diameter, commercial specifications and depth below ground surface of each casing size.)

72x72 inch diameter Concrete Curb from 0 to 12 feet  
 inch diameter from 0 to \_\_\_\_\_ feet  
 inch diameter from \_\_\_\_\_ to \_\_\_\_\_ feet  
 inch diameter from \_\_\_\_\_ to \_\_\_\_\_ feet

Describe and show depth of shoe, plug, adapter, liner or other details: \_\_\_\_\_  
 \_\_\_\_\_  
 \_\_\_\_\_

9. Perforated Casings or Screens:

\_\_\_\_\_ from \_\_\_\_\_ to \_\_\_\_\_  
(Number per foot and size of perforations, or describe screen.)  
 \_\_\_\_\_ from \_\_\_\_\_ to \_\_\_\_\_  
 \_\_\_\_\_ from \_\_\_\_\_ to \_\_\_\_\_  
 \_\_\_\_\_ from \_\_\_\_\_ to \_\_\_\_\_

10. Log of Well: (Describe each stratum or formation clearly, indicate if water bearing, and give thickness and depth as indicated.)

MATERIAL	Thickness (Feet)	Depth to Bottom (Feet)
Top Soil (Gravel)	3	3
Cemented Gravel & Cobles	31	34

If log of well is not available, give name and address of driller. Not Drilled

11. Infiltration Trench: Covered or open \_\_\_\_\_  
 Dimensions: Length \_\_\_\_\_ ft. Minimum depth \_\_\_\_\_ ft. Maximum depth \_\_\_\_\_ ft.  
 Bottom width \_\_\_\_\_ ft. Discharge \_\_\_\_\_ g.p.m. Date of test \_\_\_\_\_

12. Tunnel: Type of lining \_\_\_\_\_  
 Dimensions: \_\_\_\_\_  
(Length, course, and cross-sectional size)  
 Position of water bearing stratum with reference to portal of tunnel \_\_\_\_\_

Log of tunnel: (Preceding table for log of well may be used, if desired. Give footage from portal and character of materials, as pertinent.)

13. Pumping Equipment:  
 (a) Pump 3 inch Centrifugal Capacity 125 g.p.m.  
(Diameter, type and size)  
 (b) Motor 5 HP Motor Electric  
(Type and horsepower)

14. Location of area irrigated or to be irrigated, or place of use if for purposes other than irrigation.


Township North or South	Range E or W. of Williams-Meridian	Section	Forty-acre Tract	Number Acres To Be Irrigated	Date of Reclamation
<u>6N</u>	<u>35E</u>	<u>27</u>	<u>NW 1/4 SE 1/4</u>	<u>10</u>	<u>1922</u>

15. If the ground water supply is supplemental to an existing water supply, identification of any application for a permit, permit, certificate or adjudicated right to appropriate water made or held by the registrant.  
only water for this land is from this well

SE 1/4 of Sec 27

Township 6N Range 35E, W.M.  
North

Well located 3/4  
640 ft E and  
825 ft South  
of NW corner  
of NW 1/4

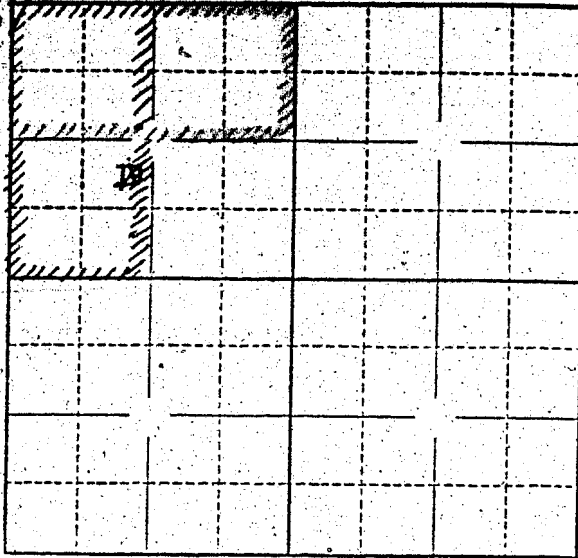

Locate well and acreage of irrigated land on plat.

Scale: 1" = 1 Mile

STATE OF OREGON

County of Umatilla

} ss.

I, Benny LeFore, being first duly sworn, do hereby certify that I have read the foregoing Registration Statement and that all of the items therein contained are true to the best of my knowledge and belief.

Benny LeFore  
(Signature of Registrant)

Subscribed and sworn to before me this 1st day of April, 1958.

My commission expires October 6th, 1960.

[Signature]  
(Notary Public)

(SEAL)

**CERTIFICATE OF REGISTRATION**

STATE OF OREGON

County of Marion

} ss.

This is to certify that the foregoing Registration Statement was received in the office of the State Engineer on the 2<sup>nd</sup> day of April, 1958, at 5:00 o'clock A. M. and has been duly recorded in said office in Book No. 6 of Registration Statements on page GR-1267

Witness my hand this 20<sup>th</sup> day of October, 1958

Lewis A. Stanley  
(State Engineer)

By \_\_\_\_\_ (Deputy)

GR - 1267