

RECEIVED

Registration No. GR 1314

Certificate No. GR 1270

Registration Statement

OF CLAIMANT OF RIGHT TO APPROPRIATE GROUND WATER

TO THE STATE ENGINEER OF OREGON:

I, Dwight L. Mc Cue

of 2247 Maple St., Forest Grove, County of Washington

State of Oregon, do hereby make application for a certificate of registration as evidence of a right to appropriate ground water.

1. Source from which water is withdrawn is Pump well #1
(Flowing well, pump well, infiltration trench, or tunnel)

2. Location is: N. E. corner city limits Forest Grove
(Approximate distance and direction from nearest city or town)

and is more particularly described as follows:

(a) S. 43° 30' E. 1250 feet from W. 1/4 corner Section 32
(Give distance and bearing to corner of section or other legal subdivision)

being within NW 1/4 of SW 1/4 of Sec. 32, Twp. 1 N, Rge. 3 W
(Smallest legal subdivision) (N. or S.) (E. or W.)

or (b) within limits of recorded platted property, town or city:

in Lot _____, Block _____ of _____
(Name of plat or addition)

County of _____
(If within city or town, give name)

3. Construction Work was begun on May 20, 1944; was completed on May 26, 1944.
(Date) (Date)

and the ground water claimed was first used for the purposes set out below on June 10, 1944
(Date)

since which time the water has been used Continuously
(Continuously or intermittently)

from 6-10-44 to 3-26-1958
(Date) (Date)

4. Quantity of water claimed and used is 25 gallons per minute; _____ acre feet per year.

5. Purpose or Purposes for which water is used Domestic and irrigation

(Domestic, irrigation, municipal, manufacturing, industrial, etc.)

6. Description of Well: Depth 54 feet. Type drilled
(Dug or drilled)

diameter 15 inches. Elevation of ground at well site 120 feet, mean sea level.
(As near as known)

Depth to water table 14 feet.

7. Capacity of Well: 35 g.p.m. with 15 feet drawdown.

_____ g.p.m. with _____ feet drawdown.


Date of test 5-28-1944

If Flowing Well: Measured discharge _____ g.p.m. on _____
(Date)

Shut-in pressure at ground surface _____ lbs. per sq. in. on _____
(Date)

Water is controlled by _____
(Cap. valve, etc.)

Township 1 N Range 3 W, W.M.
North

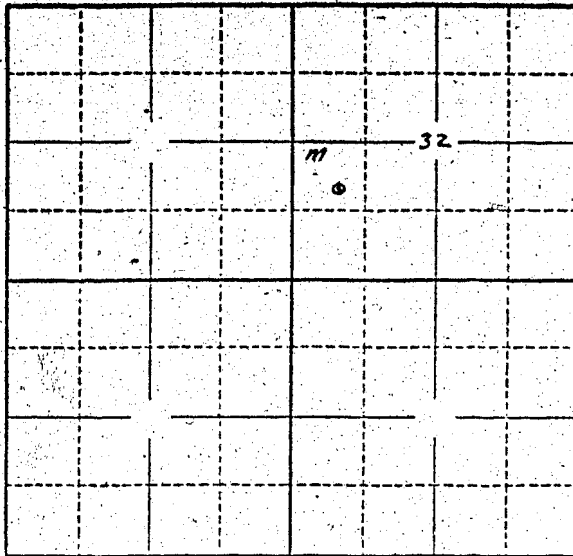

Locate well and acreage of irrigated land on plat.
Scale: 2" = 1 Mile

STATE OF OREGON

County of Washington - Marion } ss.

I, Dwight L. McCue, being first duly sworn, do hereby certify that I have read the foregoing Registration Statement and that all of the items therein contained are true to the best of my knowledge and belief.

Dwight L. McCue
(Signature of Registrant)

Subscribed and sworn to before me this 26 day of March, 1958.

My commission expires 12th June 1961

Wm. S. Bartholmeis
(Notary Public)

(SEAL)

CERTIFICATE OF REGISTRATION

STATE OF OREGON

County of Marion } ss.

This is to certify that the foregoing Registration Statement was received in the office of the State Engineer on the 15th day of April, 1958, at 5:00 o'clock A.M. and has been duly recorded in said office in Book No. 6 of Registration Statements on page GR-1270

Witness my hand this 20th day of October, 1958

Lewis A. Stanley
(State Engineer)

By _____ (Deputy)

GR-1270