

Registration No. GR 1316

Certificate No. GR 1272

Registration Statement

OF CLAIMANT OF RIGHT TO APPROPRIATE GROUND WATER

TO THE STATE ENGINEER OF OREGON:

I, Putnam Bros.

of Rte. Box 232 - Hillsboro County of Washington

State of Oregon do hereby make application for a certificate of registration as evidence of a right to appropriate ground water.

1. Source from which water is withdrawn is Pumped Well
(Flowing well, pump well, infiltration trench, or tunnel)

2. Location is: 6 miles SE of Hillsboro
(Approximate distance and direction from nearest city or town)

and is more particularly described as follows:

(a) 1123° 0' E 675 ft from South 1/4 corner Sec 29
(Give distance and bearing to corner of section or other legal subdivision)

being within South 1/4 of 26 1/4 of Sec. 29 Twp. 15 Rge. 2W
(Smallest legal subdivision) (N. or S.) (E. or W.)

or (b) within limits of recorded platted property, town or city:

in Lot _____, Block _____ of _____
(Name of plat or addition)
County of Washington
(If within city or town, give name)

3. Construction Work was begun on 1945; was completed on 1945
(Date) (Date)

and the ground water claimed was first used for the purposes set out below on 1945
(Date)

since which time the water has been used Continuously
(Continuously or intermittently)

from May to September
(Date) (Date)

4. Quantity of water claimed and used is 35 gallons per minute; _____ acre feet per year.

5. Purpose or Purposes for which water is used Irrigation - Row crops
(Domestic, irrigation, municipal, manufacturing, industrial, etc.)

6. Description of Well: Depth 505 feet. Type Drilled
(Dug or drilled)
diameter 6 inches. Elevation of ground at well site -155 feet, mean sea level.
(As near as known)
Depth to water table Flows feet.

7. Capacity of Well: 135 g.p.m. with 0 feet drawdown.
_____ g.p.m. with _____ feet drawdown.


Date of test _____

If Flowing Well: Measured discharge ? g.p.m. on _____
(Date)

Shut-in pressure at ground surface 8 lbs. per sq. in. on 1945
(Date)

Water is controlled by Valve
(Cap. valve, etc.)

Township 15 Range 2W, W.M.
North

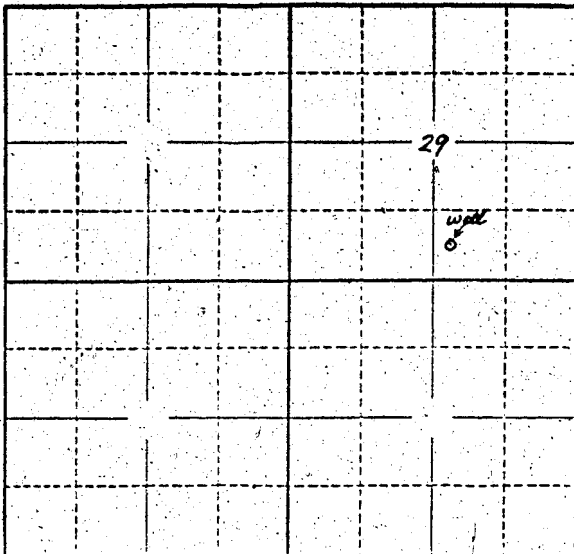

Locate well and acreage of irrigated land on plat.

Scale: 2" = 1 Mile

STATE OF OREGON

County of Marion

} ss.

I, F.C. Putnam, being first duly sworn, do hereby certify that I have read the foregoing Registration Statement and that all of the items therein contained are true to the best of my knowledge and belief.

F.C. Putnam

(Signature of Registrant)

Subscribed and sworn to before me this 26th day of March, 19 58

My commission expires 12th June 1961

Wm. S. Bartholomew

(Notary Public)

(SEAL)

CERTIFICATE OF REGISTRATION

STATE OF OREGON

County of Marion

} ss.

This is to certify that the foregoing Registration Statement was received in the office of the State Engineer on the 1st day of April, 19 58, at 8:00 o'clock A.M. and has been duly recorded in said office in Book No. 6 of Registration Statements on page GR-1272

Witness my hand this 20th day of October, 19 58

Laura A. Stanley

(State Engineer)

By

(Deputy)

GR-1272