

## Registration Statement

## OF CLAIMANT OF RIGHT TO APPROPRIATE GROUND WATER

TO THE STATE ENGINEER OF OREGON:

I, R. E. or Beegie I. Bierlyof Harrisburg  
(Mailing address)County of LinnState of Oregon, do hereby make application for a certificate of registration as evidence of a right to appropriate ground water.1. Source from which water is withdrawn is Pump well(Flowing well, pump well, infiltration trench, or tunnel)2. Location is: at Southeast edge of Harrisburg, Oregon(Approximate distance and direction from nearest city or town)

and is more particularly described as follows:

(a) S. 71° 10' E. 18.5 chains from NW corner David McCully, DLC 43.  
(Give distance and bearing to corner of section or other legal subdivision)being within SE $\frac{1}{4}$  of NW $\frac{1}{4}$  of Sec. 15, Twp. 15 S., Rge. 1 W.  
(Give exact legal subdivision)

or (b) within limits of recorded platted property, town or city:

in Lot \_\_\_\_\_, Block \_\_\_\_\_ of \_\_\_\_\_  
(Name of plat or addition)County of Linn(If within city or town, give name)3. Construction Work was begun on Nov. 1953  
(Date); was completed on Nov. 1953  
(Date)and the ground water claimed was first used for the purposes set out below on May 1954  
(Date)since which time the water has been used continuously  
(Continuously or intermittently)from May 1954 to present time  
(Date) (Date)4. Quantity of water claimed and used is 80 gallons per minute; 13.0 acre feet per year.5. Purpose or Purposes for which water is used Irrigation(Domestic, irrigation, municipal, manufacturing, industrial, etc.)6. Description of Well: Depth 50 feet. Type Drilled  
(Dug or drilled)diameter 6 inches. Elevation of ground at well site 310 feet, mean sea level.  
(As near as known)Depth to water table 18 feet.7. Capacity of Well: Not known g.p.m. with feet drawdown.g.p.m. with feet drawdown.Date of test Not testedIf Flowing Well: Measured discharge g.p.m. on (Date)Shut-in pressure at ground surface lbs. per sq. in. on (Date)Water is controlled by (Cap. valve, etc.)

**8. Casing:** (Give diameter, commercial specifications and depth below ground surface of each casing size.)

6 inch diameter steel casing from 0 to 50 feet

inch diameter from to feet

inch diameter from to feet

inch diameter from to feet

Describe and show depth of shoe, plug, adapter, liner or other details:

---

**9. Perforated Casings or Screens:**

slot perforations from 30 to 36

(Number per foot and size of perforations, or describe screen)

from bbl to 50

from to

from to

**10. Log of Well:** (Describe each stratum or formation clearly, indicate if water bearing, and give thickness and depth as indicated.)

MATERIAL	Thickness (Feet)	Depth to Bottom (Feet)
Not available		

If log of well is not available, give name and address of driller. Mac Slade, Tangent, Oregon

11. Infiltration Trench: Covered or open \_\_\_\_\_

Dimensions: Length \_\_\_\_\_ ft. Minimum depth \_\_\_\_\_ ft. Maximum depth \_\_\_\_\_ ft.

Bottom width \_\_\_\_\_ ft. Discharge \_\_\_\_\_ g.p.m. Date of test \_\_\_\_\_

12. Tunnel: Type of lining \_\_\_\_\_

Dimensions: \_\_\_\_\_  
(length, curve, and cross sectional size)

Position of water bearing stratum with reference to portal of tunnel \_\_\_\_\_

Log of tunnel: (Preceding table for log of well may be used, if desired. Give footage from portal and character of materials, as pertinent.)

13. Pumping Equipment:

(a) Pump Jacuzzi Deep well Capacity \_\_\_\_\_ 100 g.p.m.  
(make, type and size)

(b) Motor 3 H. P. Electric Capacity \_\_\_\_\_  
(Type and horsepower)


14. Location of area irrigated or to be irrigated, or place of use if for purposes other than irrigation.

Township North or South	Range E. or W. of Willamette Meridian	Section	Forty-acre Tract	Number Acres To Be Irrigated	Date of Reclamation
15 S	4 W	15	SE $\frac{1}{4}$ of NW $\frac{1}{4}$	.8	May 1954
15 S	4 W	15	SW $\frac{1}{4}$ of NE $\frac{1}{4}$	1.2	May 1954
				6.0	

15. If the ground water supply is supplemental to an existing water supply, identification of any application for a permit, permit, certificate or adjudicated right to appropriate water made or held by the registrant.

Township 15 N Range 11 W., W.M.

North

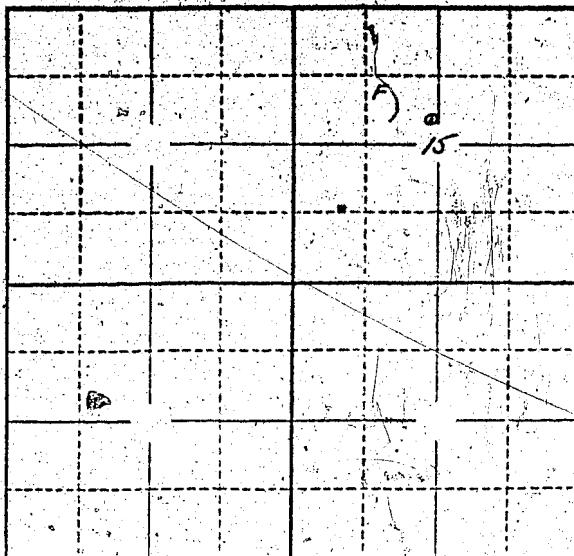

Locate well and acreage of irrigated land on plat.

Scale: 2" — 1 Mile

STATE OF OREGON

County of LINN

{ ss.

I, R. E. or Bessie L. Bierly, being first duly sworn, do hereby certify that I have read the foregoing Registration Statement and that all of the items therein contained are true to the best of my knowledge and belief.

*R. E. Bierly*  
(Signature of Registrant)

Subscribed and sworn to before me this 27th day of March, 1958.

My commission expires August 13, 1958

*Wm. E. Stanley*  
(Notary Public)

(SEAL).

#### CERTIFICATE OF REGISTRATION

STATE OF OREGON

County of Marion

{ ss.

This is to certify that the foregoing Registration Statement was received in the office of the State Engineer on the 1st day of April, 1958, at 10 A.M. o'clock M. and has been duly recorded in said office in Book No. 6 of Registration Statements on page GR- 1273.

Witness my hand this 20th day of October, 1958.

*Lewis A. Stanley*  
(State Engineer)

By

(Deputy)

GR- 1273