

Registration No. GR - 1319

Certificate No. GR - 1274

Registration Statement

OF CLAIMANT OF RIGHT TO APPROPRIATE GROUND WATER

TO THE STATE ENGINEER OF OREGON:

I, Joseph Kropf

of 735 S.W. Mill Street, Sheridan, Oregon County of Yamhill

(Mailing address)

State of Oregon, do hereby make application for a certificate of registration as evidence of a right to appropriate ground water.

1. Source from which water is withdrawn is Well (pump)
(Flowing well, pump well, infiltration trench, or tunnel)

2. Location is: 1 1/2 miles S, ± 4 miles W, of Halsey
(Approximate distance and direction from nearest city or town)

and is more particularly described as follows:

(a) South 1770', West 200' from NE corner Sec. 17
(Give distance and bearing to corner of section or other legal subdivision)

being within SE 1/4 of Sec. 17, Twp. 14S, Rge. 4 W.
(Smallest legal subdivision) (N. or S.) (E. or W.)

or (b) within limits of recorded platted property, town or city:

in Lot _____, Block _____ of _____
(Name of plat or addition)

(If within city or town, give name)

County of Linn

3. Construction Work was begun on 1953; was completed on 1953 May
(Date) (Date)

and the ground water claimed was first used for the purposes set out below on 1953 June
(Date)

since which time the water has been used continuously during irrigation seasons
(Continuously or intermittently)

from 1953 to present
(Date) (Date)

4. Quantity of water claimed and used is 65 gallons per minute; 30 acre feet per year.

5. Purpose or Purposes for which water is used Irrigation of permanent pasture

(Domestic, irrigation, municipal, manufacturing, industrial, etc.)

6. Description of Well: Depth 50 feet. Type Drilled

(Dug or drilled)

diameter 8 inches. Elevation of ground at well site 285 feet, mean sea level.
(As bear as known)

Depth to water table 12 feet.

7. Capacity of Well: 65 g.p.m. with 30 feet drawdown.

_____ g.p.m. with _____ feet drawdown.


Date of test No actual test

If Flowing Well: Measured discharge _____ g.p.m. on _____ (Date)

Shut-in pressure at ground surface _____ lbs. per sq. in. on _____ (Date)

Water is controlled by _____
(Cap. valve, etc.)

Township 14 S. Range 4 W., W.M.
North

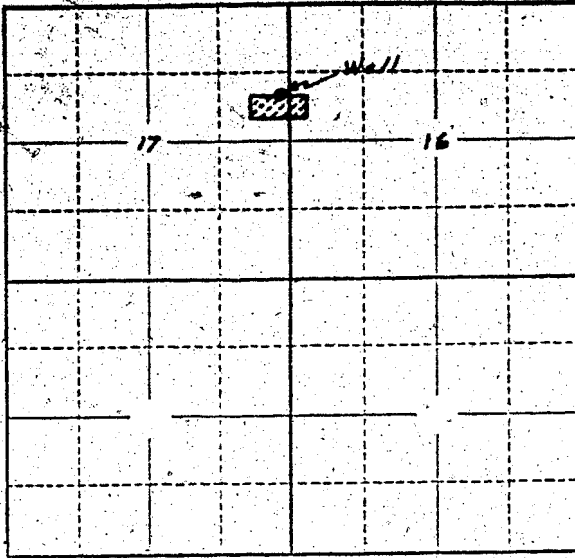

Locate well and acreage of irrigated land on plat.

Scale: 2" = 1 Mile

STATE OF OREGON

County of Marion

} ss.

I, _____, being first duly sworn, do hereby certify that I have read the foregoing Registration Statement and that all of the items therein contained are true to the best of my knowledge and belief.

Joseph Ruff
(Signature of Registrant)

Subscribed and sworn to before me this 2nd day of April, 1958

My commission expires 12th June 1961

Wm. S. Bartholomew
(Notary Public)

(SEAL)

CERTIFICATE OF REGISTRATION

STATE OF OREGON

County of Marion

} ss.

This is to certify that the foregoing Registration Statement was received in the office of the State Engineer on the 2nd day of April, 1958, at 10⁰⁰ o'clock A. M. and has been duly recorded in said office in Book No. 6 of Registration Statements on page GR-1274

Witness my hand this 20th day of October, 1958

Lewis A. Stanley
(State Engineer)

By _____

(Deputy)

GR-1274