

RECEIVED

FEB 23 1956

STATE ENGINEER
SALEM, OREGON

Registration Statement

REGISTRATION NO. GR-132

CERTIFICATE NO. GR-123

OF CLAIMANT OF RIGHT TO APPROPRIATE GROUND WATER

(Under Chapter 708, Oregon Laws 1955.)

TO THE STATE ENGINEER OF OREGON:

I, Howard Wm. and Marilyn K. Boyte

of Rt. 2 Box 19 Tigard County of Washington

State of Oregon, do hereby make application for a certificate of registration as evidence of a right to appropriate ground water.

1. Source from which water is withdrawn is Pump Well

(Flowing well, pump well, infiltration trench, or tunnel)

2. Location is: 2 mi. SW of Tigard Oregon

(Approximate distance and direction from nearest city or town)

and is more particularly described as follows:

(a) East 566 ft of Lot 1 M. Ochs Tract

(Give distance and bearing to corner of section or other legal subdivision)

being within NW 1/4 SW 1/4 of Sec. 11 Twp. T. 2 S. Rge. R1W W.M.

(Smallest legal subdivision)

(N. or S.)

(E. or W.)

or (b) within limits of recorded platted property, town or city: Tigard

in Lot One, Block _____ of Marguete Ochs Tracts

(Name of plat or addition)

Tigard County of Washington

(If within city or town, give name)

3. Construction Work was begun on Dec 52; was completed on Feb 28, 1953

(Date)

(Date)

and the ground water claimed was first used for the purposes set out below on March, 1953

(Date)

since which time the water has been used Continuously in house and intermittently for yard

(Continuously or intermittently)

from April to Oct

(Date)

(Date)

4. Quantity of water claimed and used is 10 gallons per minute; One acre feet per year.

5. Purpose or Purposes for which water is used Domestic and irrigation of yard and garden

(Domestic, irrigation, municipal, manufacturing, industrial, etc.)

6. Description of Well: Depth 162 feet. Type drilled

(Dug or drilled)

diameter 6 inches. Elevation of ground at well site 325 275 feet sea level

(As near as known)

Depth to water table 110 feet.

7. Capacity of Well: 18 g.p.m. with None feet drawdown.

Unk g.p.m. with _____ feet drawdown.

Date of test Feb 28 1953

If Flowing Well: Measured discharge NA g.p.m. on _____ (Date)

Shut-in pressure at ground surface NA lbs. per sq. in. on _____ (Date)

Water is controlled by NA

(Cap, valve, etc.)

8. Casing: (Give diameter, commercial specifications and depth below ground surface of each casing size.)

6 inch diameter Steel Well Casing from 0 to 30 feet
6 inch diameter Rock from 30 to 162 feet
inch diameter from to feet
inch diameter from to feet

Describe and show depth of shoe, plug, adapter, liner or other details:

9. Perforated Casings or Screens:

none from to
(Number per foot and size of perforations, or describe screen)
from to
from to
from to

10. Log of Well: (Describe each stratum or formation clearly, indicate if water bearing, and give thickness and depth as indicated.)

MATERIAL	Thickness (Feet)	Depth to Bottom (Feet)
Log Not available		

If log of well is not available, give name and address of driller. Lance W Strayer
Rt 1 Box 450 Beaverton Oregon

out 11. Infiltration Trench: Covered or open
Dimensions: Length ft. Minimum depth ft. Maximum depth ft.
Bottom width ft. Discharge g.p.m. Date of test

out 12. Tunnel: Type of lining
Dimensions:
(Length, course, and cross sectional size)
Position of water bearing stratum with reference to portal of tunnel

Log of tunnel: (Preceding table for log of well may be used, if desired. Give footage from portal and character of materials, as pertinent.)

13. Pumping Equipment:
(a) Pump Sumo 722315 2.0 H.P. Capacity 10.44 g.p.m.
(Make, type and size)
(b) Motor 2.0 H.P.
(Type and horsepower)


14. Location of area irrigated or to be irrigated, or place of use if for purposes other than irrigation.

Township North or South	Range E. or W. of Williamsite Meridian	Section	Forty-acre Tract	Number Acres To Be Irrigated	Date of Reclamation
<u>25</u>	<u>1W W.M.</u>	<u>11</u>	<u>NW 1/4 SW 1/4</u>	<u>2.2</u>	<u>1 June 1953</u>

15. If the ground water supply is supplemental to an existing water supply, identification of any application for a permit, permit, certificate or adjudicated right to appropriate water made or held by the registrant.
.....
.....

Sec 11 Township T.25 Range R.1W., W.M.
North

Irrigated area
2.2.A

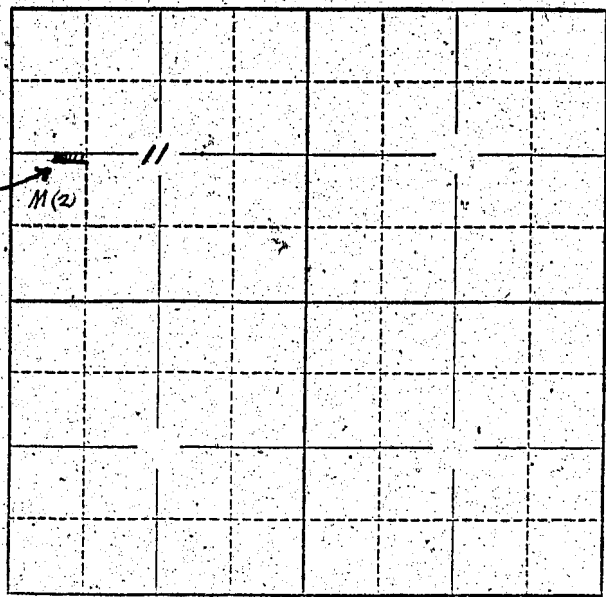

Locate well and acreage of irrigated land on plat.
Scale: 2" = 1 Mile

STATE OF OREGON

County of Washington } ss.

I, Howard William Boyte and
I, Marilyn K. Boyte, being first duly sworn, do hereby certify that I have
read the foregoing Registration Statement and that all of the items therein contained are true to the best of
my knowledge and belief.

Marilyn K. Boyte

Howard Boyte
(Signature of Registrant)

Subscribed and sworn to before me this 21st day of February, 1956.

My commission expires Oct. 25, 1958

Thylis M. Anderson
(Notary Public)

(SEAL)

CERTIFICATE OF REGISTRATION

STATE OF OREGON

County of Marion } ss.

This is to certify that the foregoing Registration Statement was received in the office of the State
Engineer on the 23rd day of February, 1956, at 8:00 o'clock A.M. and has been
duly recorded in said office in Book No. 1 of Registration Statements on page GR-123C

~~Construction shall be completed by 1956 and the water completely applied for
benefit to be used by 1956.~~

Witness my hand this 12th day of April, 1956.

Lewis A. Stanek
(State Engineer)

By _____
(Deputy)

GR-123 C