

RECEIVED
APR 3 1958
STATE ENGINEER
SALEM, OREGON

Registration No. GR - 1327
Certificate No. GR - 1282

Registration Statement

OF CLAIMANT OF RIGHT TO APPROPRIATE GROUND WATER

TO THE STATE ENGINEER OF OREGON:

I, Julio W. Silva and Elizabeth M. Silva
of Box 5317 Eugene County of LANE
State of OREGON, do hereby make application for a certificate of registration as evidence
of a right to appropriate ground water.

1. Source from which water is withdrawn is Pump Well #3
(Flowing well, pump well, infiltration trench, or tunnel)
2. Location is: 8 1/2 mi. SE Eugene
(Approximate distance and direction from nearest city or town)

and is more particularly described as follows:

- (a) S 72° 30' W 1500' from NE Cor. Sec 12
(Give distance and bearing to corner of section or other legal subdivision)
being within NW 1/4 NE of Sec. 12, Twp. 18 S, Rge. 3 W
(Smallest legal subdivision) (N. or S.) (E. or W.)
- (b) within limits of recorded platted property, town or city:

in Lot _____, Block _____ of _____
(Name of plat or addition)
County of _____
(If within city or town, give name)

3. Construction Work was begun on Feb 1953; was completed on Feb 1953
(Date) (Date)
and the ground water claimed was first used for the purposes set out below on April 1953
(Date)
since which time the water has been used Continuously
(Continuously or intermittently)
from April 1953 to 1958
(Date) (Date)

4. Quantity of water claimed and used is 400 gallons per minute; _____ acre
feet per year.

5. Purpose or Purposes for which water is used irrigation
(Domestic, irrigation, municipal, manufacturing, industrial, etc.)

6. Description of Well: Depth 24 feet. Type driven
(Dug or drilled)
diameter 2-3" pipe inches. Elevation of ground at well site _____ feet, mean sea level.
(As near as known)
Depth to water table 9 feet.

7. Capacity of Well: _____ g.p.m. with _____ feet drawdown.
_____ g.p.m. with _____ feet drawdown.
Date of test No test

If Flowing Well: Measured discharge _____ g.p.m. on _____
(Date)

Shut-in pressure at ground surface _____ lbs. per sq. in. on _____
(Date)

Water is controlled by _____
(Cap, valve, etc.)

8. Casing: (Give diameter, commercial specifications and depth below ground surface of each casing size.)

2-3" pipe inch diameter from 0 to 24 feet
 inch diameter from to feet
 inch diameter from to feet
 inch diameter from to feet

Describe and show depth of shoe, plug, adapter, liner or other details: _____

9. Perforated Casings or Screens:

3.5 feet from to
 (Number per foot and size of perforations, or describe Screen)
 from to
 from to
 from to

10. Log of Well: (Describe each stratum or formation clearly, indicate if water bearing, and give thickness and depth as indicated.)

MATERIAL	Thickness (Feet)	Depth to Bottom (Feet)
Sand and gravel		

If log of well is not available, give name and address of driller:

11. Infiltration Trench: Covered or open

Dimensions: Length ft. Minimum depth ft. Maximum depth ft.

Bottom width ft. Discharge g.p.m. Date of test

12. Tunnel: Type of lining

Dimensions:
(Length, cover, and cross sectional size)

Position of water bearing stratum with reference to portal of tunnel

Log of tunnel: (Preceding table for log of well may be used, if desired. Give footage from portal and character of materials, as pertinent.)

13. Pumping Equipment:

(a) Pump #3 Cent Capacity 400 g.p.m.
(Make, type and size)


(b) Motor Gas
(Type and horsepower)

14. Location of area irrigated or to be irrigated, or place of use if for purposes other than irrigation.

Township North or South	Range E. or W. of Willamette Meridian	Section	Forty-acre Tract	Number Acres To Be Irrigated	Date of Reclamation
185	3W	12	NE 1/4 NW 1/4	3.7	1953
			NW 1/4 NE 1/4	40.0	
			SW 1/4 NE 1/4	4.9	
			NE 1/4 NE 1/4	38.2	
			SE 1/4 NE 1/4	20.0	
175	3W	1	SE 1/4 SW 1/4	4.1	
			SW 1/4 SE 1/4	7.6	
			SE 1/4 SE 1/4	0.3	
175		7	NW 1/4 NW 1/4	5.1	
		6	SW 1/4 SW 1/4	0.7	
				<u>124.6</u>	

15. If the ground water supply is supplemental to an existing water supply, identification of any application for a permit, permit, certificate or adjudicated right to appropriate water made or held by the registrant.

Township 18S Range 3W W.M.
North

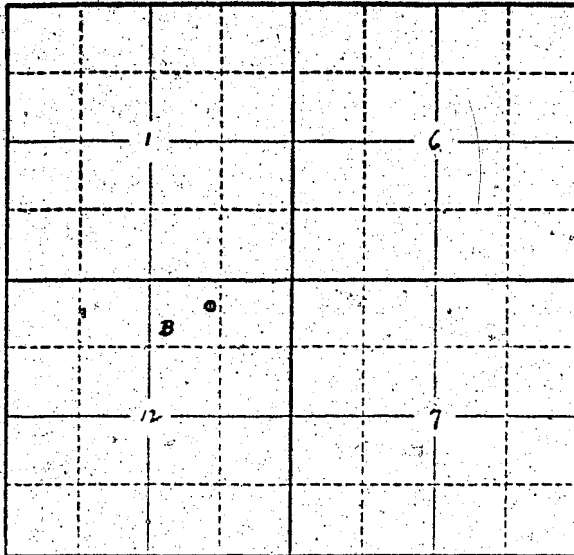

Map in
Application
32,229

Locate well and acreage of irrigated land on plat.
Scale: 2" = 1 Mile

STATE OF OREGON }
County of Lane } ss.

I, Julius Selva, being first duly sworn, do hereby certify that I have read the foregoing Registration Statement and that all of the items therein contained are true to the best of my knowledge and belief.

Julius Selva
(Signature of Registrant)

Subscribed and sworn to before me this 1st day of April, 1958.

My commission expires 12th June 1961 Wm. S. Bartholmeis
(Notary Public)

(SEAL)

CERTIFICATE OF REGISTRATION

STATE OF OREGON }
County of Marion } ss.

This is to certify that the foregoing Registration Statement was received in the office of the State Engineer on the 3rd day of April, 1958, at 10:00 o'clock AM and has been duly recorded in said office in Book No. 6 of Registration Statements on page GR-1282

Witness my hand this 20th day of October, 1958

Lawrence A. Stanley
(State Engineer)

By _____
(Deputy)