

RECEIVED
FEB 21 1955

Registration Statement

OF CLAIMANT OF RIGHT TO APPROPRIATE GROUND WATER

(Under Chapter 708, Oregon Laws 1955.)

TO THE STATE ENGINEER OF OREGON:

I, Andrew E. Stevens 5055 Pacific Highway, South
of ~~Jackson~~ Medford County of Jackson
State of Oregon, do hereby make application for a certificate of registration as evidence
of a right to appropriate ground water.

1. Source from which water is withdrawn is infiltration trench
(flowing well, pump well, infiltration trench, or tunnel)
2. Location is: 6 mi south of Medford, Ore.
(Approximate distance and direction from nearest city or town)

and is more particularly described as follows: 1491' N. and 1250' W from S.E. cor. Sec. 15

(a) Donation Land Claim # 43
NE 1/4 Sec. 15 (Give distance and bearing to corner of section or other legal subdivision)

being within S.E. Cor. D.L.C. # 43 of Sec. 15, Twp. 38 S, Rge. 1 W.
(Smallest legal subdivision) (N. or S.) (E. or W.)

or (b) within limits of recorded platted property, town or city:

in Lot _____ Block _____ of _____
(Name of plat or addition)

County of _____
(If within city or town, give name)

3. Construction Work was begun on 1905; was completed on 1920
(Date) (Date)

and the ground water claimed was first used for the purposes set out below on 1905
(Date)

since which time the water has been used Continuously
(Continuously or intermittently)
from 1905 to 1955
(Date) (Date)

4. Quantity of water claimed and used is 550 gallons per minute; 4.5 acre
feet per year.

5. Purpose or Purposes for which water is used Irrigation

Sump (Domestic, irrigation, municipal, manufacturing, industrial, etc.)

6. Description of Well: Depth 10 feet. Type Dug Trench
(Dug or drilled)

diameter _____ inches. Elevation of ground at well site 1520' feet, mean sea level.
(As near as known)

Depth to water table unknown feet.

7. Capacity of Well: _____ g.p.m. with _____ feet drawdown.

_____ g.p.m. with _____ feet drawdown.

Date of test _____

If Flowing Well: Measured discharge _____ g.p.m. on _____
(Date)

Shut-in pressure at ground surface _____ lbs. per sq. in. on _____
(Date)

Water is controlled by _____
(Cap, valve, etc.)

8. Casing: (Give diameter, commercial specifications and depth below ground surface of each casing size.)

..... inch diameter *No.* from to feet
..... inch diameter from to feet
..... inch diameter from to feet
..... inch diameter from to feet

Describe and show depth of shoe, plug, adapter, liner or other details:

9. Perforated Casings or Screens:

 No. from to
(Number per foot and size of perforations, or describe screen)
..... from to
..... from to
..... from to

10. Log of Well: (Describe each stratum or formation clearly, indicate if water bearing, and give thickness and depth as indicated.)

MATERIAL	Thickness (Feet)	Depth to Bottom (Feet)

If log of well is not available, give name and address of driller. _____

11. Infiltration Trench: Covered or open Open
 Dimensions: Length 800 ft. Minimum depth 3 ft. Maximum depth 10 ft.
 Bottom width 8 ft. Discharge _____ g.p.m. Date of test _____

12. Tunnel: Type of lining _____
 Dimensions: _____
 (Length, course, and cross sectional size)
 Position of water bearing stratum with reference to portal of tunnel _____

Log of tunnel: (Preceding table for log of well may be used, if desired. Give footage from portal and character of materials, as pertinent.)


13. Pumping Equipment:
 (a) Pump Pasma Water lift Capacity 550 g.p.m.
 (Make, type and size)
 (b) Motor Electric - 5 H.P.
 (Type and horsepower)

14. Location of area irrigated or to be irrigated, or place of use if for purposes other than irrigation.

Township North or South	Range E. or W. of Willamette Meridian	Section	Forty-acre Tract	Number Acres To Be Irrigated	Date of Reclamation
38 S	1 W	15	SE 1/4	approx 30	1905
38 S	1 W	15	NE 1/4 SE 1/4	18.0 acres	1910
38 S	1 W	15	SE 1/4 SE 1/4	12.0 acres	1905

15. If the ground water supply is supplemental to an existing water supply, identification of any application for a permit, permit, certificate or adjudicated right to appropriate water made or held by the registrant.

Township 38 Range 1 W, W.M.
North

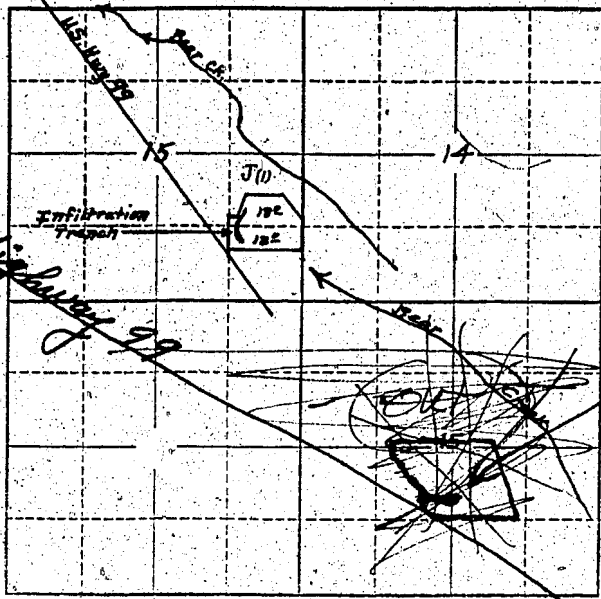

approx. 30 ft
800 ft
infiltration
trench.

Locate well and acreage of irrigated land on plat.
Scale: 2" = 1 Mile

STATE OF OREGON

County of _____ } ss.

I, _____, being first duly sworn, do hereby certify that I have read the foregoing Registration Statement and that all of the items therein contained are true to the best of my knowledge and belief.

Andrew E. Stevens
(Signature of Registrant)

Subscribed and sworn to before me this 2nd day of February, 1956

My commission expires August 25, 1958 *Regl. C. P. ...*
(Notary Public)

(SEAL)

CERTIFICATE OF REGISTRATION

STATE OF OREGON

County of Marion } ss.

This is to certify that the foregoing Registration Statement was received in the office of the State Engineer on the 21st day of February, 1956, at 1:00 o'clock P.M. and has been duly recorded in said office in Book No. 1 of Registration Statements on page GR-124C

~~Construction shall be completed by _____ 19____ and the water completely applied to beneficial use by _____~~

Witness my hand this 12th day of April, 1956.

Lewis A. Stanley
(State Engineer)

By _____ (Deputy)

GR-124C