

RECEIVED
APR 3 1958

STATE ENGINEER
SALEM, OREGON

Registration No. GR - 1334

Certificate No. GR - 1289

Registration Statement

OF CLAIMANT OF RIGHT TO APPROPRIATE GROUND WATER

TO THE STATE ENGINEER OF OREGON:

I, Jay and Luann Richardson

of Rt. 1, Box 270, Albany
(Mailing address)

County of Linn

State of Oregon, do hereby make application for a certificate of registration as evidence of a right to appropriate ground water.

1. Source from which water is withdrawn is Puro Well 4
(Flowing well, pump well, infiltration trench, or tunnel)

2. Location is: 9 miles East of Albany, Oregon
(Approximate distance and direction from nearest city or town)

and is more particularly described as follows:

(a) 990' S. and 1584' W. of NE corner S. 5, T. 11 S, R. 2 W.W.M.
(Give distance and bearing to corner of section or other legal subdivision)

being within NW 1/4 of NE 1/4 of Sec. 5, Twp. 11 S, Rge. 2 W
(Consistent legal subdivision) (N. or S.) (E. or W.)

or (b) within limits of recorded platted property, town or city:

in Lot _____, Block _____ of _____
(Name of plat or addition)

County of Linn
(If within city or town, give name)

3. Construction Work was begun on April 1947; was completed on April 1947
(Date) (Date)

and the ground water claimed was first used for the purposes set out below on June 1947
(Date)

since which time the water has been used continuously
(Continuously or intermittently)

from June 1947 to present time
(Date) (Date)

4. Quantity of water claimed and used is 200 gallons per minute; 37.5 acre feet per year.

5. Purpose or Purposes for which water is used Irrigation
(Domestic, irrigation, municipal, manufacturing, industrial, etc.)

6. Description of Well: Depth 28 feet. Type Drilled
(Dug or drilled)

diameter _____ inches. Elevation of ground at well site 255 feet, mean sea level.
(As near as known)

Depth to water table 16 feet.

7. Capacity of Well: Don't know g.p.m. with _____ feet drawdown.

_____ g.p.m. with _____ feet drawdown.

Date of test _____

If Flowing Well: Measured discharge _____ g.p.m. on _____
(Date)

Shut-in pressure at ground surface _____ lbs. per sq. in. on _____
(Date)

Water is controlled by _____
(Cap. valve, etc)

If log of well is not available, give name and address of driller. Unknown

11. Infiltration Trench: Covered or open _____

Dimensions: Length _____ ft. Minimum depth _____ ft. Maximum depth _____ ft.

Bottom width _____ ft. Discharge _____ g.p.m. Date of test _____

12. Tunnel: Type of lining _____

Dimensions: _____
(Length, course, and cross-sectional size)

Position of water bearing stratum with reference to portal of tunnel _____

Log of tunnel: (Preceding table for log of well may be used, if desired. Give footage from portal and character of materials, as pertinent.)

13. Pumping Equipment:

(a) Pump Allis Chalmers 2" centrifugal Capacity 250 g.p.m.
(Make, type and size)

(b) Motor 7 1/2 H.P. electric
(Type and horsepower)

14. Location of area irrigated or to be irrigated, or place of use if for purposes other than irrigation.


Township North or South	Range E. or W. of Williamsite Meridian	Section	Forty-acre Tract	Number Acres To Be Irrigated	Date of Reclamation
11 S	2 W	5	SW ¹ / ₄ of NE ¹ / ₄	3.5	June 1947
11 S	2 W	5	NW ¹ / ₄ of NE ¹ / ₄	5.5	" "
11 S	2 W	5	NE ¹ / ₄ of NE ¹ / ₄	1.0	" "
11 S	2 W	5	SE ¹ / ₄ of NE ¹ / ₄	5.0	June 1958
				15.0	

Beginning at the Northeast corner of the D.L.C. of John A. Powell and wife, Not. No. 1197 and Claim No. 40 in T. 11 S., R. 2W. of the W.M. in Linn County, Oregon; thence South 18°45' West along the East line of said claim 18.48 chains to an iron rod 1 inch by 30 inches; thence North 71°15' West parallel with the North line of said Claim 7.80 chains to an iron rod 1 inch by 30 inches; thence North 19°30' East 10.38 chains, to an iron rod 1 inch by 30 inches; thence North 71°15' West parallel with the North line of said claim, 4.77 chains to an iron rod 1 inch by 30 inches; thence North 19°30' East 8.10 chains to an iron rod 1 inch by 30 inches on the North line of said claim; thence South 71°15' East 12.42 chains to the place of beginning.

ALSO Beginning at an iron rod 1 by 30 inches, which is South 18°45' West 8.10 chains distant and North 71°15' West 7.65 chains distant from the Northeast corner of the Donation Land Claim of John A. Powell and wife, same being Not. No. 1197 and Claim No. 40 in Township No. 11 S., R. 2W. of the W.M., Oregon, and running thence North 71°15' West parallel with the North line of said Claim 4.77 chains to an iron rod 1 by 30 inches; thence South 19°30' West 21.90 chains to the center of the County Road; thence East along the center of the said County Road 5.06 chains, to a point which is West 8.37 chains distant from the East line of said Donation Land Claim; thence North 19°30' East 20.14 chains, to the place of beginning, containing 10 acres more or less, all lying in the County of Linn, State of Oregon.

15. If the ground water supply is supplemental to an existing water supply, identification of any application for a permit, permit, certificate or adjudicated right to appropriate water made or held by the registrant.

Township 11 S Range 2 E W.M.
North

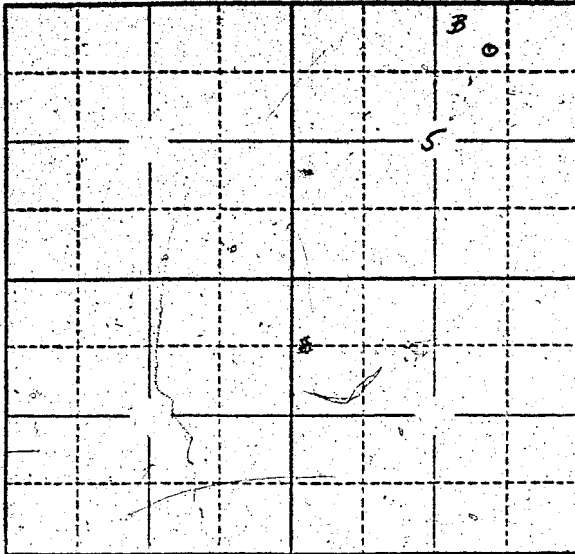

Locate well and acreage of irrigated land on plat.
Scale: 2" = 1 Mile

STATE OF OREGON

County of Linn } ss.

I, Jay and Luanne Richardson, being first duly sworn, do hereby certify that I have read the foregoing Registration Statement and that all of the items therein contained are true to the best of my knowledge and belief.

Jay Richardson
Luanne Richardson
(Signatures of Registrant)

Subscribed and sworn to before me this 1 day of April, 1958

My commission expires April 1961

[Signature]
(Notary Public)

(SEAL)

CERTIFICATE OF REGISTRATION

STATE OF OREGON } ss.
County of Marion

This is to certify that the foregoing Registration Statement was received in the office of the State Engineer on the 3rd day of April, 1958, at 8:50 o'clock A. M. and has been duly recorded in said office in Book No. 6 of Registration Statements on page 62-1289

Witness my hand this 20th day of October, 1958

[Signature]
(State Engineer)

By _____ (Deputy)