

**RECEIVED**  
APR 3 1953  
STATE ENGINEER  
SALEM, OREGON

Registration No. GR - 1335  
Certificate No. GR - 1290

### Registration Statement

#### OF CLAIMANT OF RIGHT TO APPROPRIATE GROUND WATER

TO THE STATE ENGINEER OF OREGON:

I, C. J. Sylvester

of 1520 Nordparkway Rd. County of Tillamook

State of Oregon, do hereby make application for a certificate of registration as evidence of a right to appropriate ground water.

1. Source from which water is withdrawn is Pump well #1  
(Flowing well, pump well, infiltration trench, or tunnel)

2. Location is: 4 mi N. of Eugene  
(Approximate distance and direction from nearest city or town)

and is more particularly described as follows:

(a) 350 ft west & 120 ft south of N.W. cor. Sec. 24.  
(Give distance and bearing to corner of section or other legal subdivision)

being within NE 1/4 of NE 1/4 of Sec. 24, Twp. 17 S, Rge. 4 W  
(Smallest legal subdivision) (T or S) (E or W)

or (b) within limits of recorded platted property, town or city:

in Lot \_\_\_\_\_, Block \_\_\_\_\_ of \_\_\_\_\_  
(Name of plat or addition)

County of \_\_\_\_\_  
(If within city or town, give name)

3. Construction Work was begun on Aug 19 35; was completed on Aug 19 35  
(Date) (Date)

and the ground water claimed was first used for the purposes set out below on Aug 19 35  
(Date)

since which time the water has been used Continuously  
(Continuously or intermittently)

from Aug 19 35 to Present  
(Date) (Date)

4. Quantity of water claimed and used is 200 gallons per minute; 50 acre feet per year.

5. Purpose or Purposes for which water is used Domestic Irrigation

(Domestic, irrigation, municipal, manufacturing, industrial, etc.)

6. Description of Well: Depth 3-30 feet. Type 1 Hauled E 3 inches  
(Dug or drilled)

diameter 3-12 inches. Elevation of ground at well site \_\_\_\_\_ feet, mean sea level.  
(As near as known)

Depth to water table 17 feet. 4 Connected each 20 feet apart

7. Capacity of Well: \_\_\_\_\_ g.p.m. with \_\_\_\_\_ feet drawdown.

\_\_\_\_\_ g.p.m. with \_\_\_\_\_ feet drawdown.

Date of test Not Tested

If Flowing Well: Measured discharge \_\_\_\_\_ g.p.m. on \_\_\_\_\_  
(Date)

Shut-in pressure at ground surface \_\_\_\_\_ lbs. per sq. in. on \_\_\_\_\_  
(Date)

Water is controlled by \_\_\_\_\_  
(Cap. valve, etc.)

8. Casing: (Give diameter, commercial specifications and depth below ground surface of each casing size.)

3 wells 1 1/2 inch diameter galvanized pipe from 0 to 30 feet  
 1 well 4" inch diameter steel well casing from 45 ft 0 to 96 feet  
 inch diameter from to feet  
 inch diameter from to feet

Describe and show depth of shoe, plug, adapter, liner or other details:

9. Perforated Casings or Screens:

Driven & shot with dynamite from to  
 (Number per foot and size of perforations, or describe screen)  
 trench slots 1/2" x 1" 5/ft. from 92 to 96  
 from to  
 from to

10. Log of Well: (Describe each stratum or formation clearly, indicate if water bearing, and give thickness and depth as indicated.)

MATERIAL	Thickness (Feet)	Depth to Bottom (Feet)
?		

If log of well is not available, give name and address of driller.

11. Infiltration Trench: Covered or open \_\_\_\_\_

Dimensions: Length \_\_\_\_\_ ft. Minimum depth \_\_\_\_\_ ft. Maximum depth \_\_\_\_\_ ft.

Bottom width \_\_\_\_\_ ft. Discharge \_\_\_\_\_ g.p.m. Date of test \_\_\_\_\_

12. Tunnel: Type of lining \_\_\_\_\_

Dimensions: \_\_\_\_\_ (Length, course, and cross sectional size)

Position of water bearing stratum with reference to portal of tunnel \_\_\_\_\_

Log of tunnel: (Preceding table for log of well may be used, if desired. Give footage from portal and character of materials, as pertinent.)

13. Pumping Equipment:

(a) Pump 2" Centrifugal Flow Control 2 1/2" Capacity 200 g.p.m.  
(Make, type and size)


(b) Motor 7/8 HP. elec.  
(Type and horsepower)

14. Location of area irrigated or to be irrigated, or place of use if for purposes other than irrigation.

Township North or South	Range E. or W. of Williamsite Meridian	Section	Forty-acre Tract	Number Acres To Be Irrigated	Date of Reclamation
17-S	4-W	24	N.E. 1/4 of N.E. 1/4	12.0	1935
"	3W	19	N.W. 1/4 of N.W. 1/4	8.0	"
				20.0 <u>Ac</u>	

15. If the ground water supply is supplemental to an existing water supply, identification of any application for a permit, permit, certificate or adjudicated right to appropriate water made or held by the registrant.

Township 175 Range 7 W W.M.  
North

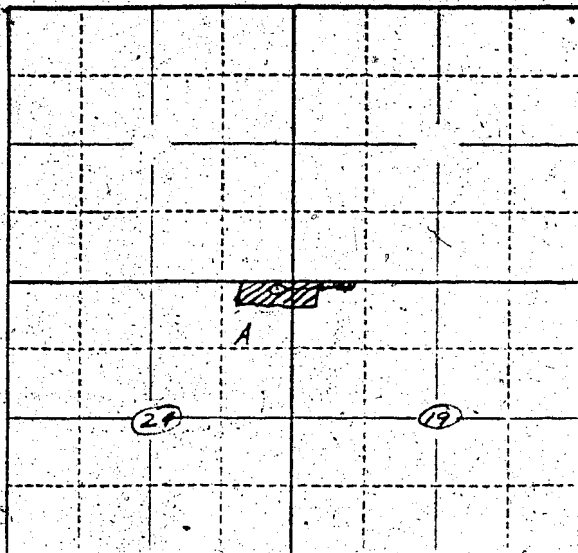

Locate well and acreage of irrigated land on plat.  
Scale: 2" = 1 Mile

STATE OF OREGON

County of Marion

} ss.

I, \_\_\_\_\_, being first duly sworn, do hereby certify that I have read the foregoing Registration Statement and that all of the items therein contained are true to the best of my knowledge and belief.

*G. J. [Signature]*  
(Signature of Registrant)

Subscribed and sworn to before me this 1st day of April, 1958

My commission expires 12th June 1961

*Wm. S. Bartholomew*  
(Notary Public)

(SEAL)

**CERTIFICATE OF REGISTRATION**

STATE OF OREGON

County of Marion

} ss.

This is to certify that the foregoing Registration Statement was received in the office of the State Engineer on the 30th day of April, 1958, at 5:00 o'clock A.M. and has been duly recorded in said office in Book No. 6 of Registration Statements on page GR-1299

Witness my hand this 20th day of October, 1958

*Wm. A. Stanley*  
(State Engineer)

By \_\_\_\_\_

(Deputy)