

RECEIVED
FEB 2 1955
STATE ENGINEER
SALEM, OREGON

REGISTRATION NO. CR-134
CERTIFICATE NO. GR-125

Registration Statement

OF CLAIMANT OF RIGHT TO APPROPRIATE GROUND WATER

(Under Chapter 708, Oregon Laws 1955.)

TO THE STATE ENGINEER OF OREGON:

I, John B Nelson
of Rt 1 Box 360 Hubbard County of Marion
State of Oregon, do hereby make application for a certificate of registration as evidence
of a right to appropriate ground water.

1. Source from which water is withdrawn is pump well
(Flowing well, pump well, infiltration trench, or tunnel)
2. Location is: Three miles North and West of Hubbard Ore
(Approximate distance and direction from nearest city or town)

and is more particularly described as follows:

(a) 1000 feet South and 600 feet east from west 1/4 corner.
(Give distance and bearing to corner of section or other legal subdivision)
being within NW 1/4 SW 1/4 of Sec. 21, Twp. 4 S, Rge. 1 W
(Smallest legal subdivision) (N. or S.) (E. or W.)

or (b) within limits of recorded platted property, town or city:
in Lot _____, Block A of _____
(Name of plat or addition)

County of Marion
(If within city or town, give name)

3. Construction Work was begun on 3/50; was completed on 3/50
(Date) (Date)
and the ground water claimed was first used for the purposes set out below on 4/50
(Date)
since which time the water has been used continuously
(Continuously or intermittently)
from 4/50 to 1/56
(Date) (Date)

4. Quantity of water claimed and used is 90 gallons per minute; _____ acre
feet per year.

5. Purpose or Purposes for which water is used House and irrigation
(Domestic, irrigation, municipal, manufacturing, industrial, etc.)

6. Description of Well: Depth 100 feet. Type drilled
(Dug or drilled)
diameter 6 inches. Elevation of ground at well site _____ feet, mean sea level.
(As near as known)
Depth to water table 24 feet.

7. Capacity of Well: _____ g.p.m. with 10 feet drawdown.
_____ g.p.m. with _____ feet drawdown.

Date of test 3/50

If Flowing Well: Measured discharge 90 g.p.m. on 3/50
(Date)

Shut-in pressure at ground surface 50 lbs. per sq. in. on _____
(Date)

Water is controlled by valves
(Cap, valve, etc.)

8. Casing: (Give diameter, commercial specifications and depth below ground surface of each casing size.)

6 inch diameter from to 100 feet
 inch diameter from to feet
 inch diameter from to feet
 inch diameter from to feet

Describe and show depth of shoe, plug, adapter, liner or other details:

.....

9. Perforated Casings or Screens:

none from to
(Number per foot and size of perforations, or describe screen)
 from to
 from to
 from to

10. Log of Well: (Describe each stratum or formation clearly, indicate if water bearing, and give thickness and depth as indicated.)

MATERIAL	Thickness (Feet)	Depth to Bottom (Feet)
<i>no record available</i>		

If log of well is not available, give name and address of driller: John Miller

11. Infiltration Trench: Covered or open

Dimensions: Length ft. Minimum depth ft. Maximum depth ft.

Bottom width ft. Discharge g.p.m. Date of test

12. Tunnel: Type of lining

Dimensions:
(Length, course, and cross sectional size)

Position of water bearing stratum with reference to portal of tunnel

Log of tunnel: (Preceding table for log of well may be used, if desired. Give footage from portal and character of materials, as pertinent.)

13. Pumping Equipment:

(a) Pump Sears Jet Capacity g.p.m.
(Make, type and size)

(b) Motor Upright - 1 horse
(Type and horsepower)

14. Location of area irrigated or to be irrigated, or place of use if for purposes other than irrigation.


Township North or South	Range E. or W. of Willamette Meridian	Section	Forty-acre Tract	Number Acres To Be Irrigated	Date of Reclamation
T 45	1W	21	NW 1/4 SW 1/4	6	April 4, 1950

Beginning at a point South 15° 24' West and along the East line of the Whitney Donation Land Claim in Township 4, Range 1 West 30.19 chains from the Northeast corner of the Whitney Donation Land Claim is an iron bar in the center of a County Road and thence North 75° 5' West along the centerline of road, 12.92 chains to the Southeast corner of land conveyed to Douty in Volume 349, Page 612. This point being beginning point for the tract conveyed; thence North 14° 55' East along the East line of Douty Tract 9.00 chains to the Northeast corner of said tract. Thence North 75° 5' West 11.389 chains to the West line of tract conveyed to Hodges Volume 357, page 392 thence North 71° 13' East 6.32 chains to an iron pipe; North 45° 44' East 15.814 chains South 15° 24' West 25.705 chains to the centerline of county road; thence North 75° 15' West along centerline of road 1.515 chains to point of beginning. Containing 10.067 acres.

15. If the ground water supply is supplemental to an existing water supply, identification of any application for a permit, permit, certificate or adjudicated right to appropriate water made or held by the registrant.

S.W. 21

Township 4 S Range 1 W, W.M. North

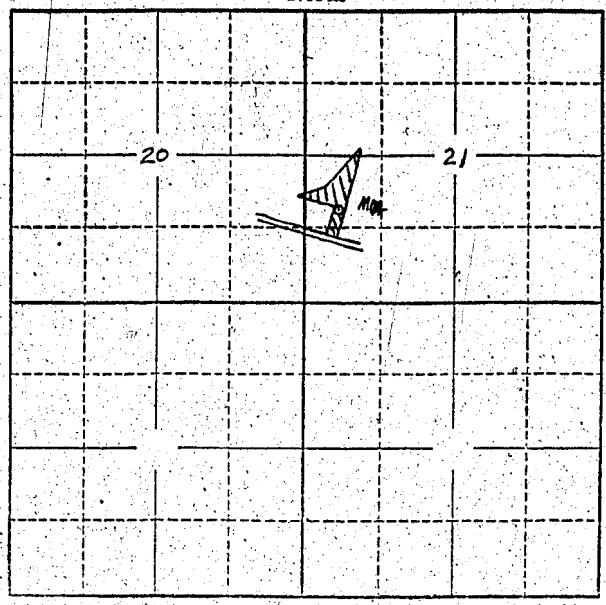

Locate well and acreage of irrigated land on plat.
Scale: 2" = 1 Mile

STATE OF OREGON }
County of Marion } ss.

I, John B. Nelsen, being first duly sworn, do hereby certify that I have read the foregoing Registration Statement and that all of the items therein contained are true to the best of my knowledge and belief.

John B. Nelsen
(Signature of Registrant)

Subscribed and sworn to before me this 17 day of February, 1956.

My commission expires July 30, 1950 D. H. Mills
(Notary Public)

(SEAL)

CERTIFICATE OF REGISTRATION

STATE OF OREGON }
County of Marion } ss.

This is to certify that the foregoing Registration Statement was received in the office of the State Engineer on the 21st day of February, 1956, at 8:00 o'clock A. M. and has been duly recorded in said office in Book No. 1 of Registration Statements on page GR-125C.

~~Construction shall be completed by _____ and the water certificate applied for hereafter by _____~~

Witness my hand this 12th day of April, 1956.

Lewis A. Stanley
(State Engineer)

By _____
(Deputy)