

Registration No. GR - 1310

Certificate No. GR - 1296

# Registration Statement

## OF CLAIMANT OF RIGHT TO APPROPRIATE GROUND WATER

TO THE STATE ENGINEER OF OREGON:

I, Andrew Joseph Bishop & Hazel Bishop

of Rt. 1 Box 12 Aumsville

(Mailing address)

County of Malheur

State of Oregon, do hereby make application for a certificate of registration as evidence of a right to appropriate ground water.

1. Source from which water is withdrawn is trench #2

(Flowing well, pump well, infiltration trench, or tunnel)

2. Location is: 1 mile East & 1/2 mile South of Aumsville

(Approximate distance and direction from nearest city or town)

and is more particularly described as follows:

(a) N 57° E 1/4 North & 1/2 E 1/4 East from 1/4 corner on S. line Sec. 31, T 83 R 1 W

(Give distance and bearing to corner of section or other legal subdivision)

being within NW 1/4 of SE 1/4 of Sec. 31, Twp. 8 S, Rge. 1 W

(Smallest legal subdivision)

(N. or S.)

(E. or W.)

or (b) within limits of recorded platted property, town or city:

in Lot \_\_\_\_\_, Block \_\_\_\_\_ of \_\_\_\_\_

(Name of plat or addition)

County of \_\_\_\_\_

(If within city or town, give name)

3. Construction Work was begun on May 1959, was completed on May 1955

(Date)

(Date)

and the ground water claimed was first used for the purposes set out below on June 1954

(Date)

since which time the water has been used intermittently

(Continuously or Intermittently)

from June 1957 to present

(Date)

(Date)

4. Quantity of water claimed and used is 360 gallons per minute; 88.8 acre feet per year.

5. Purpose or Purposes for which water is used irrigation

(Domestic, irrigation, municipal, manufacturing, industrial, etc.)

6. Description of Well: Depth \_\_\_\_\_ feet. Type \_\_\_\_\_

(Dug or drilled)

diameter \_\_\_\_\_ inches. Elevation of ground at well site 400 feet, mean sea level.

(As near as known)

Depth to water table \_\_\_\_\_ feet.

7. Capacity of Well: 360 g.p.m. with 24 feet drawdown.

\_\_\_\_\_ g.p.m. with \_\_\_\_\_ feet drawdown.

Date of test \_\_\_\_\_

If Flowing Well: Measured discharge \_\_\_\_\_ g.p.m. on \_\_\_\_\_

(Date)

Shut-in pressure at ground surface \_\_\_\_\_ lbs. per sq. in. on \_\_\_\_\_

(Date)


Water is controlled by \_\_\_\_\_

(Cap, valve, etc.)





Township 8.5 Range 1 W, W.M.  
North

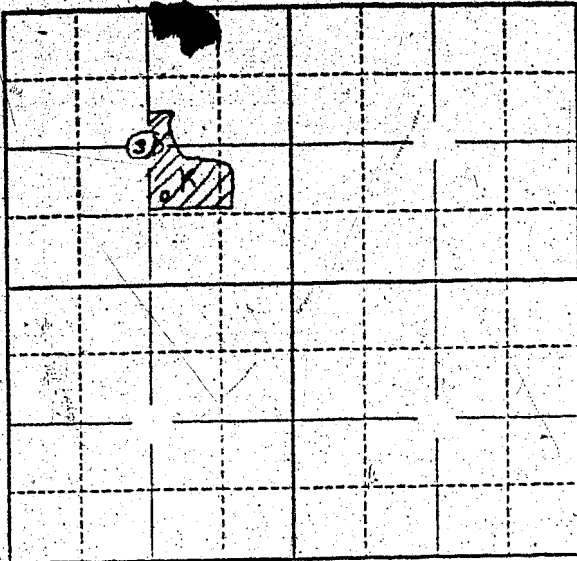

Locate well and acreage of irrigated land on plat.  
Scale: 2" = 1 Mile

STATE OF OREGON

County of Marion } ss.

I, Andrew J. and Hazel Bishop, being first duly sworn, do hereby certify that I have read the foregoing Registration Statement and that all of the items therein contained are true to the best of my knowledge and belief.

Andrew J. Bishop Hazel Bishop  
(signature of Registrant)

Subscribed and sworn to before me this 13th day of March, 1958.

My commission expires March 15, 1958

Alfred T. Kettner  
(Notary Public)

(SEAL)

### CERTIFICATE OF REGISTRATION

STATE OF OREGON

County of Marion } ss.

This is to certify that the foregoing Registration Statement was received in the office of the State Engineer on the 4 day of April, 1958, at 10<sup>00</sup> o'clock A. M. and has been duly recorded in said office in Book No. 6 of Registration Statements on page GR-1296.

Witness my hand this 20<sup>th</sup> day of October, 1958

Lewis A. Stanley  
(State Engineer)

By

(Deputy)

GR-1296