

RECEIVED
APR 4 1958
STATE ENGINEER
SALEM, OREGON

Registration No. GR - 1314
Certificate No. GR - 1300

Registration Statement

OF CLAIMANT OF RIGHT TO APPROPRIATE GROUND WATER

TO THE STATE ENGINEER OF OREGON:

I, Urie E. Kenagy

of Route 4, Box 600, Albany County of Benton
(Mailing address)

State of Oregon, do hereby make application for a certificate of registration as evidence of a right to appropriate ground water.

1. Source from which water is withdrawn is pump well #2
(Flowing well, pump well, infiltration trench, or tunnel)

2. Location is: 2 miles north of Albany
(Approximate distance and direction from nearest city or town)

600 feet east & 2000 ft. No. from SW cor. Sect. 32
and is more particularly described as follows: Beginning at an iron rod which is S 89° 46' E 4.50 chains distant from the SW corner of the NW 1/4 of Sec. 32 in T 10S, R 3W, of W.M., Benton County,

(a) Oregon, thence S 0° 2' E 640.4'; thence E 395.0' to wall.
(Give distance and bearing to corner of section or other legal subdivision)

being within NE 1/4 of SW 1/4 of Sec. 32, Twp. 10S Rge. 34
(Smallest legal subdivision) (N. or S.) (E. or W.)

or (b) within limits of recorded platted property, town or city:

in Lot _____, Block _____ of _____
(Name of plat or addition)

County of Benton

(If within city or town, give name)

3. Construction Work was begun on Autumn, 1938; was completed on Autumn, 1938
(Date) (Date)

and the ground water claimed was first used for the purposes set out below on Summer, 1939
(Date)

since which time the water has been used continuously during summer months
(Continuously or intermittently)

from Summer, 1939 to present time.
(Date) (Date)

4. Quantity of water claimed and used is 168 gallons per minute; 43 acre feet per year.

5. Purpose or Purposes for which water is used irrigation

(Domestic, irrigation, municipal, manufacturing, industrial, etc.)

6. Description of Well: Depth 18 feet. Type dug
(Dug or drilled)
diameter 2 1/2' x 2 1/2' inches. Elevation of ground at well site 185 feet, mean sea level.
(As near as known)

Depth to water table 10 feet.

7. Capacity of Well: 168 g.p.m. with 8 feet drawdown.

g.p.m. with _____ feet drawdown.

Date of test 1939

If Flowing Well: Measured discharge _____ g.p.m. on _____


(Date)

Shut-in pressure at ground surface _____ lbs. per sq. in. on _____

(Date)

Water is controlled by _____
(Cap. valve, etc.)

Township 10 S Range 24 W.M.
North

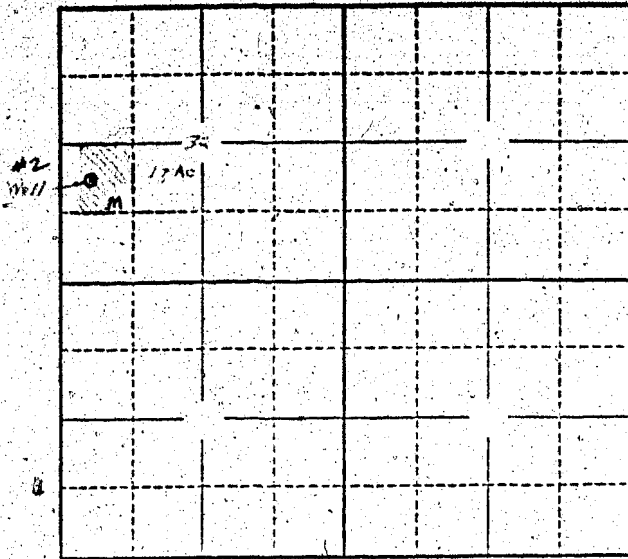

Locate well and acreage of irrigated land on plat.

Scale: 2" = 1 Mile

STATE OF OREGON

County of Linn } ss.

I, Urie E. Kenagy, being first duly sworn, do hereby certify that I have read the foregoing Registration Statement and that all of the items therein contained are true to the best of my knowledge and belief.

Urie E. Kenagy
(Signature of Registrant)

Subscribed and sworn to before me this 2nd day of April, 1958.

MY COMMISSION EXPIRES DEC. 4, 1958

My commission expires
(Notary Public)

(SEAL)

CERTIFICATE OF REGISTRATION

STATE OF OREGON }
County of Marion } ss.

This is to certify that the foregoing Registration Statement was received in the office of the State Engineer on the 4th day of April, 1958, at o'clock M. and has been duly recorded in said office in Book No. 6 of Registration Statements on page GR 1300

Witness my hand this 20th day of October, 1958.

(State Engineer)

By
(Deputy)