

RECEIVED
APR 4 1958
STATE ENGINEER
SALEM, OREGON

Registration No. GR - 1315
Certificate No. GR - 1301

Registration Statement

OF CLAIMANT OF RIGHT TO APPROPRIATE GROUND WATER

TO THE STATE ENGINEER OF OREGON:

I, H. K. Ross

of Bt. 1 Harrisburg County of Linn

State of Ore., do hereby make application for a certificate of registration as evidence of a right to appropriate ground water.

1. Source from which water is withdrawn is Pump Well
(Flowing well, pump well, infiltration trench, or tunnel)

2. Location is: Quarter S. of Harrisburg
(Approximate distance and direction from nearest city or town)

and is more particularly described as follows:

(a) 5940' N. 70° 15' W. of SE corner Sec. 2 T16S, R4W
(Give distance and bearing to corner of section or other legal subdivision)

being within NE 1/4 of NW 1/4 of Sec. 2, Twp. 16 S, Rge. 4 W
(Smallest legal subdivision) (N. or S.) (E. or W.)

or (b) within limits of recorded platted property, town or city:

in Lot _____, Block _____ of _____
(Name of plat or addition)

County of _____
(If within city or town, give name)

3. Construction Work was begun on April 1941; was completed on April 1941
(Date) (Date)

and the ground water claimed was first used for the purposes set out below on April 1941
(Date)

since which time the water has been used intermittently
(Continuously or intermittently)

from April 1941 to present
(Date) (Date)

4. Quantity of water claimed and used is 180 gallons per minute; 17.5 acre feet per year.

5. Purpose or Purposes for which water is used irrigation

(Domestic, irrigation, municipal, manufacturing, industrial, etc.)

6. Description of Well: Depth 20 feet. Type Driven
(Dug or drilled)

diameter 2" pipe inches. Elevation of ground at well site _____ feet, mean sea level.
(As near as known)

Depth to water table 10 feet.

7. Capacity of Well: 200 g.p.m. with 5 feet drawdown.

_____ g.p.m. with _____ feet drawdown.


Date of test April 1941

If Flowing Well: Measured discharge _____ g.p.m. on _____
(Date)

Shut-in pressure at ground surface _____ lbs. per sq. in. on _____
(Date)

Water is controlled by _____
(Cap, valve, etc.)

Township 16 S Range 2 W W.M.
North

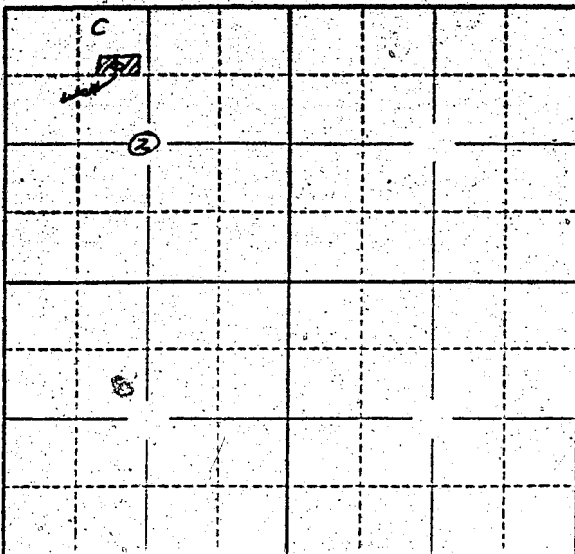

Locate well and acreage of irrigated land on plat.
Scale: 2" = 1 Mile

STATE OF OREGON

County of Linn } ss.

I, H. L. Ross, being first duly sworn, do hereby certify that I have read the foregoing Registration Statement and that all of the items therein contained are true to the best of my knowledge and belief.

H L Ross

(Signature of Registrant)

Subscribed and sworn to before me this 14th day of March, 19 58

My commission expires August 13, 1958

W. L. Stanley
Notary Public for Oregon

(SEAL)

CERTIFICATE OF REGISTRATION

STATE OF OREGON

County of Marion } ss.

This is to certify that the foregoing Registration Statement was received in the office of the State Engineer on the 4th day of April, 19 58, at 5:00 o'clock A. M. and has been duly recorded in said office in Book No. 6 of Registration Statements on page GR-1301

Witness my hand this 20th day of October, 19 58

Lewis A. Stanley
(State Engineer)

By _____ (Deputy)