

8. Casing: (Give diameter, commercial specifications and depth below ground surface of each casing size.)

56 inch diameter reinforced 3' 1 3/4" concrete from top to 8 feet
 inch diameter from to feet
 inch diameter from to feet
 inch diameter from to feet

Describe and show depth of shoe, plug, adapter, liner or other details:

9. Perforated Casings or Screens:

Number of about 2.5 inches in diameter
 (Number per foot and size of perforations, or describe screen)


from 0 to
 from to
 from to
 from to

10. Log of Well: (Describe each stratum or formation clearly, indicate if water bearing, and give thickness and depth as indicated.)

MATERIAL	Thickness (Feet)	Depth to Bottom (Feet)
Heavily silty clay loam & sandy loam	5	5
Unconsolidated gravels water bearing	5	10
Blue clay	1	11

(Bottom of well does not penetrate through the clay layer)

Township 16 S Range 3 W W.M.
North

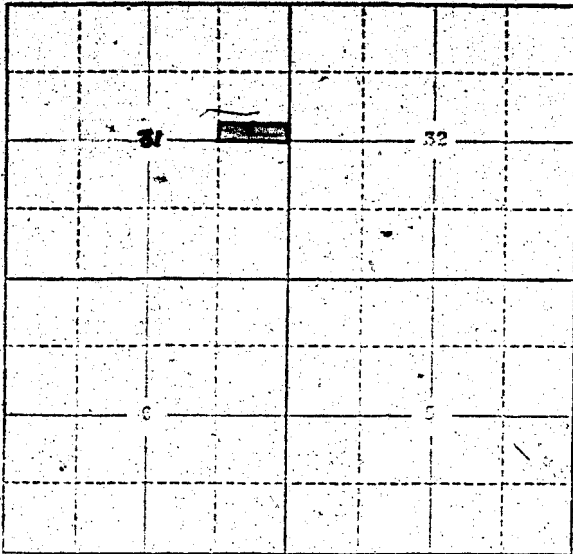

Locate well and acreage of irrigated land on plat.
Scale: 2" = 1 Mile

STATE OF OREGON

County of Marion } ss.

I, Lo Sidwell, being first duly sworn, do hereby certify that I have read the foregoing Registration Statement and that all of the items therein contained are true to the best of my knowledge and belief.

Lo Sidwell
(Signature of Registrant)

Subscribed and sworn to before me this 17th day of March 1958.

My commission expires Aug 3, 1958
(Notary Public)

(SEAL)

CERTIFICATE OF REGISTRATION

STATE OF OREGON

County of Marion } ss.

This is to certify that the foregoing Registration Statement was received in the office of the State Engineer on the 4th day of April, 1958, at 1:00 o'clock P. M. and has been duly recorded in said office in Book No. 6 of Registration Statements on page GR-1304.

Witness my hand this 20th day of October, 1958.

Lewis A. Strubley
(State Engineer)

By _____ (Deputy)

GR-1304