

RECEIVED

APR 4 1958

STATE ENGINEER
SALEM, OREGON

Registration Statement

Registration No. GR - 1319

Certificate No. GR - 1305

OF CLAIMANT OF RIGHT TO APPROPRIATE GROUND WATER

TO THE STATE ENGINEER OF OREGON:

I, Olaf Ege

of Rt. 2, Box 228, Eugene

County of Jane

State of Oregon, do hereby make application for a certificate of registration as evidence of a right to appropriate ground water.

1. Source from which water is withdrawn is pump well
(Flowing well, pump well, infiltration trench, or tunnel)

2. Location is: 2 miles N.E. of Eugene
(Appropriate distance and direction from nearest city or town)

and is more particularly described as follows:

(a) 650' E - 2360' S from the NW corner Sec 14
(Give distance and bearing to corner of section or other legal subdivision)

being within SW/NW of Sec. 14, Twp. 12S, Rge. 3W
(Smallest legal subdivision) (S, or S.) (E or W)

or (b) within limits of recorded platted property, town or city:

in Lot _____, Block _____ of _____
(Name of plat or addition)

County of _____
(If within city or town, give name)

3. Construction Work was begun on April 21, 1951; was completed on April 21, 1951
(Date) (Date)

and the ground water claimed was first used for the purposes set out below on April 1951
(Date)

since which time the water has been used Cont.
(Continuously or intermittently)

from May to Sept
(Date) (Date)

4. Quantity of water claimed and used is 80 gallons per minute; 12 1/2 acre feet per year.

5. Purpose or Purposes for which water is used Irrigation
(Domestic, irrigation, municipal, manufacturing, industrial, etc.)

6. Description of Well: Depth 21 feet. Type driven
(Dug or drilled)

diameter 4" inches. Elevation of ground at well site _____ feet, mean sea level.

Depth to water table 8' feet.
(As near as known)

7. Capacity of Well: _____ g.p.m. with _____ feet drawdown.

_____ g.p.m. with _____ feet drawdown.


Date of test _____

If Flowing Well: Measured discharge _____ g.p.m. on _____
(Date)

Shut-in pressure at ground surface _____ lbs. per sq. in. on _____
(Date)

Water is controlled by _____
(Cap, valve, etc.)

Township 17S Range 3W W.M.
North

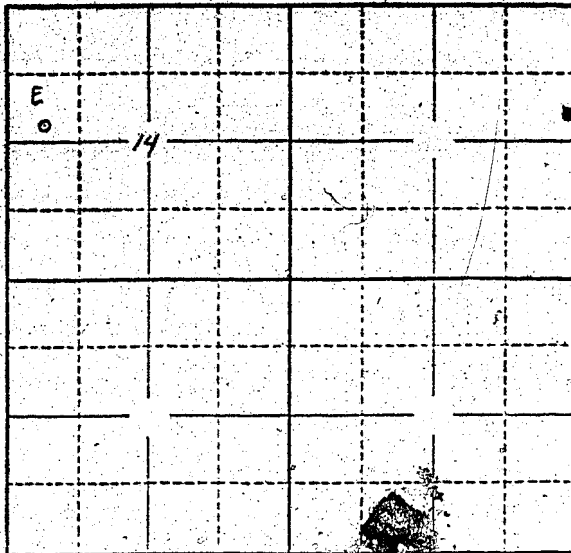

Locate well and acreage of irrigated land on plat.
Scale: 2" = 1 Mile

STATE OF OREGON

County of _____

ss.

I, _____ being first duly sworn, do hereby certify that I have read the foregoing Registration Statement and that all of the items therein contained are true to the best of my knowledge and belief.

(Signature of Registrant)

Subscribed and sworn to before me this _____ day of _____, 19____.

My commission expires _____

(Notary Public)

(SEAL)

CERTIFICATE OF REGISTRATION

STATE OF OREGON

County of Marion

ss.

This is to certify that the foregoing Registration Statement was received in the office of the State Engineer on the 4th day of April, 1958, at 1:00 o'clock P. M. and has been duly recorded in said office in Book No. 6 of Registration Statements on page GR-1305

Witness my hand this 20th day of October, 1958.

Lewis A. Stanley
(State Engineer)

By _____

(Deputy)

GR - 1305