

RECEIVED

APR 4 1958

STATE ENGINEER
SALEM, OREGON

Registration Statement

Registration No. GR - 1350

Certificate No. GR - 1306

OF CLAIMANT OF RIGHT TO APPROPRIATE GROUND WATER

TO THE STATE ENGINEER OF OREGON:

I, Helga M. Strong
of 1522 Charleston St. Eugene County of Lane
(Mailing address)

State of Oregon, do hereby make application for a certificate of registration as evidence of a right to appropriate ground water:

1. Source from which water is withdrawn is Pump well - sump
(Flowing well, pump well, infiltration trench, or tunnel)

2. Location is: 5 1/2 miles north of Eugene
(Approximate distance and direction from nearest city or town)

and is more particularly described as follows:

(a) 2440 ft. West + 227 ft. South from S.E. cor. Thos. S. Poindexter
(Give distance and bearing to corner of section or other legal subdivision) DLC

being within NW 1/4 of SW 1/4 of Sec. 2, Twp. 17 S., Rge. 4 W.
(Subtract legal subdivision) (N. or S.) (E. or W.)

or (b) within limits of recorded platted property, town or city:

in Lot _____ Block _____ of _____
(Name of plat or addition)

County of _____
(If within city or town, give name)

3. Construction work was begun on 1945; was completed on 1946
(Date) (Date)

and the ground water claimed was first used for the purposes set out below on June 1946
(Date)

since which time the water has been used intermittently
(Continuously or intermittently)

from June 1946 to Sept. 1957
(Date) (Date)

4. Quantity of water claimed and used is 240 gallons per minute; 87.5 acre feet per year.

5. Purpose or Purposes for which water is used IRRIGATION
(Domestic, irrigation, municipal, manufacturing, industrial, etc.)

6. Description of Well: Depth 17 feet. Type Dug
(Dug or drilled)

diameter 42 inches. Elevation of ground at well site _____ feet, mean sea level.
(As near as known)

Depth to water table 6 feet.

7. Capacity of Well: _____ g.p.m. with _____ feet drawdown.

_____ g.p.m. with _____ feet drawdown.

Date of test NOT KNOWN

If Flowing Well: Measured discharge _____ g.p.m. on _____
(Date)

Shut-in pressure at ground surface _____ lbs. per sq. in. on _____
(Date)

Water is controlled by _____
(Cap, valve, etc.)

8. Casing: (Give diameter, commercial specifications and depth below ground surface of each casing size.)

4.2 inch diameter Precast Circular Concrete from 0 to 17 feet
 inch diameter _____ from _____ to _____ feet
 inch diameter _____ from _____ to _____ feet
 inch diameter _____ from _____ to _____ feet

Describe and show depth of shoe, plug, adapter, liner or other details: _____

9. Perforated Casings or Screens:

2" x 10" slits 5/ft from 3' to 6'
(Number per foot and size of perforations, or describe screen)
 _____ from _____ to _____
 _____ from _____ to _____
 _____ from _____ to _____

10. Log of Well: (Describe each stratum or formation clearly, indicate if water bearing, and give thickness and depth as indicated.)

MATERIAL	Thickness (Feet)	Depth to Bottom (Feet)
Don't know		

If log of well is not available, give name and address of driller. _____

11. Infiltration Trench: Covered or open _____

Dimensions: Length _____ ft. Minimum depth _____ ft. Maximum depth _____ ft.

Bottom width _____ ft. Discharge _____ g.p.m. Date of test _____

12. Tunnel: Type of lining _____

Dimensions: _____
(Length, curve, and cross sectional size)

Position of water bearing stratum with reference to portal of tunnel _____

Log of tunnel: (Preceding table for log of well may be used, if desired. Give footage from portal and character of materials, as pertinent.)

13. Pumping Equipment:

(a) Pump Pacific 2 1/2" CENTRIFUGAL Capacity 300 g.p.m.
(State type and size)

(b) Motor 15 H.P. ELECTRIC
(Type and horsepower)


14. Location of area irrigated or to be irrigated, or place of use if for purposes other than irrigation.

Township North or South	Range E. or W. of Williamsite Meridian	Section	Four-acre Tract	Number Acres To Be Irrigated	Date of Reclamation
175	4W	2	NW 1/4 of SW 1/4	13.2	JUNE 1946
175	4W	2	NE 1/4 of SW 1/4	12.9	"
175	4W	3	NE 1/4 of SE 1/4	9.7	"
				35.8 ac.	

15. If the ground water supply is supplemental to an existing water supply, identification of any application for a permit, permit, certificate or adjudicated right to appropriate water made or held by the registrant.

CERTIFICATE OF WATER RIGHT 30491

Township 17 S Range 14 W W.M.
North

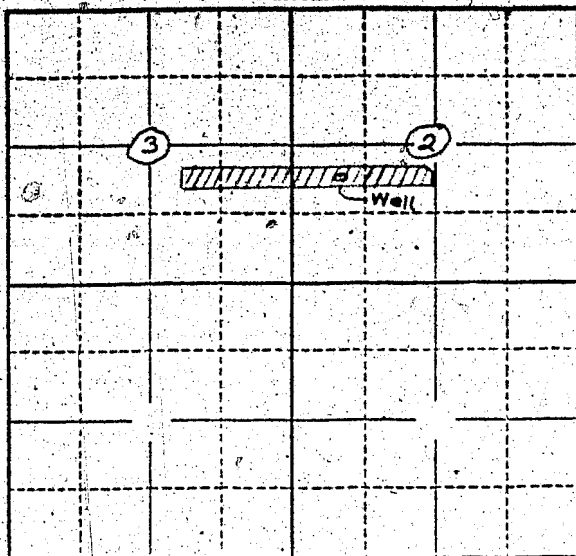

Locate well and acreage of irrigated land on plat.
Scale: 2" = 1 Mile

STATE OF OREGON

County of Marion } ss.

I, Helga M. Strong, being first duly sworn, do hereby certify that I have read the foregoing Registration Statement and that all of the items therein contained are true to the best of my knowledge and belief.

Helga M. Strong
(Signature of Registrant)

Subscribed and sworn to before me this 1st day of April, 1958

My commission expires 12th June 1961

Wm. S. Bartholomew
(Notary Public)

(SEAL)

CERTIFICATE OF REGISTRATION

STATE OF OREGON

County of Marion } ss.

This is to certify that the foregoing Registration Statement was received in the office of the State Engineer on the 4th day of April, 1958, at 1:55 o'clock P.M. and has been duly recorded in said office in Book No. 6 of Registration Statements on page 66-1306

Witness my hand this 20th day of October, 1958

Lewis A. Stanley
(State Engineer)

By _____ (Deputy)