

Registration Statement

OF CLAIMANT OF RIGHT TO APPROPRIATE GROUND WATER

TO THE STATE ENGINEER OF OREGON:

I, Frank Etzel

of Sublimity, Oregon County of Marion
(Mailing address)

State of Oregon, do hereby make application for a certificate of registration as evidence of a right to appropriate ground water.

1. Source from which water is withdrawn is Pump Well
(Flowing well, pump well, infiltration trench, or tunnel)

2. Location is: 1/2 Mile East of Sublimity, Oregon
(Approximate distance and direction from nearest city or town)

and is more particularly described as follows:

(a) 42 Feet North and 126 feet East of Quarter Section Cor. on W. Side of Sec. 35
(Give distance and bearing to corner of section or other legal subdivision)

being within S. W. 1/4 of N. W. 1/4 of Sec. 35, Twp. 8 S., Rge. 1 W.
(Smallest legal subdivision) (N. or S.) (E. or W.)

or (b) within limits of recorded platted property, town or city:

in Lot _____, Block _____ of _____
(Name of plat or addition)

County of _____
(If within city or town, give name)

3. Construction Work was begun on 15 Sept. 1944; was completed on 1 Oct. 1944
(Date) (Date)

and the ground water claimed was first used for the purposes set out below on 15 June 1945
(Date)

since which time the water has been used Continuously
(Continuously or intermittently)

from 15 June 1945 to Date
(Date) (Date)

4. Quantity of water claimed and used is 225 gallons per minute; 2.80 acre feet per year.

5. Purpose or Purposes for which water is used Irrigation of row crops

(Domestic, irrigation, municipal, manufacturing, industrial, etc.)

6. Description of Well: Depth 186 feet. Type Drilled
(Dug or drilled)

diameter 6 inches. Elevation of ground at well site 300 feet, mean sea level.
(As near as known)

Depth to water table 65 feet.

7. Capacity of Well: 250 g.p.m. with _____ feet drawdown. From experience
no test available
 _____ g.p.m. with _____ feet drawdown.


Date of test _____

If Flowing Well: Measured discharge _____ g.p.m. on _____
(Date)

Shut-in pressure at ground surface _____ lbs. per sq. in. on _____
(Date)

Water is controlled by _____
(Cap, valve, etc.)

Township 8 S. Range 1 W., W.M.
North

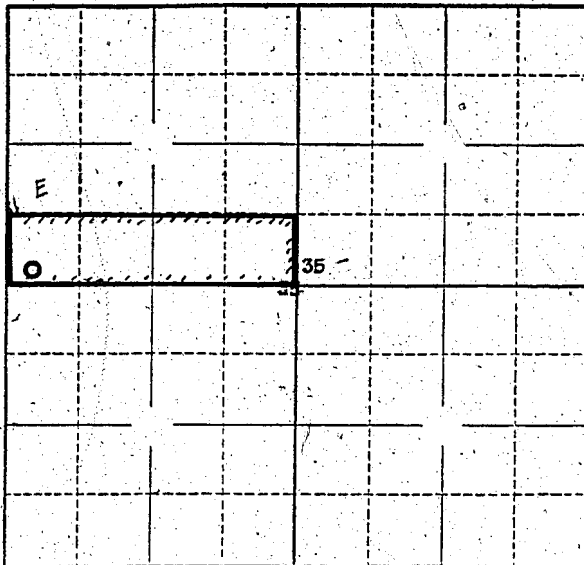

Well 42 Feet
North and 126
feet East of
W $\frac{1}{4}$ Sec. Cor.

Locate well and acreage of irrigated land on plat.

Scale: $\frac{1}{4}$ " = 1 Mile

4" = 1 "

STATE OF OREGON

County of Marion

} ss.

I, Frank Etzel, being first duly sworn, do hereby certify that I have read the foregoing Registration Statement and that all of the items therein contained are true to the best of my knowledge and belief.

Frank Etzel
(Signature of Registrant)

Subscribed and sworn to before me this 29th day of March, 1958

My commission expires Dec 14 1960
E. D. Carter
(Notary Public)

(SEAL)

CERTIFICATE OF REGISTRATION

STATE OF OREGON

County of Marion

} ss.

This is to certify that the foregoing Registration Statement was received in the office of the State Engineer on the 4th day of April, 1958, at 1:00 o'clock P. M. and has been duly recorded in said office in Book No. 6 of Registration Statements on page GR-1307

Witness my hand this 20th day of October, 1958

Lewis A. Stanley
(State Engineer)

By _____
(Deputy)