

Registration Statement

OF CLAIMANT OF RIGHT TO APPROPRIATE GROUND WATER

TO THE STATE ENGINEER OF OREGON:

I, Emmett E. Woodward and Amy E. Woodward

of Rt. 2 Box 259C Hillsboro County of Washington

State of Oregon, do hereby make application for a certificate of registration as evidence of a right to appropriate ground water.

- 1. Source from which water is withdrawn is Flowing well, pump well
(Flowing well, pump well, infiltration trench, or tunnel)
- 2. Location is: About 4 miles South of Hillsboro, Oregon on River Road
(Approximate distance and direction from nearest city or town)

and is more particularly described as follows:

(a) S 85° 50' W 1451' from N.E. Corner Sec. 21
(Give distance and bearing to corner of section or other legal subdivision)

being within NW 1/4 NE 1/4 of Sec. 21, Twp. 1S, Rge. 2W
(Smallest legal subdivision) (N. or S.) (E. or W.)

or (b) within limits of recorded platted property, town or city:

in Lot _____, Block _____ of _____
(Name of plat or addition)

County of _____
(If within city or town, give name)

3. Construction Work was begun on February 1952; was completed on March 17, 1953
(Date) (Date)

and the ground water claimed was first used for the purposes set out below on except to use in 1953
since which time the water has been used intermittently from next year or so
(Continuously or Intermittently)

from 1953 to 1958
(Date)

we expect to use

4. Quantity of water claimed and used is 15 gallons per minute; 10 acre feet per year.

5. Purpose or Purposes for which water is used to be To irrigate 8 acres crop land

(Domestic, irrigation, municipal, manufacturing, industrial, etc.)

6. Description of Well: Depth 211 feet. Type drilled

(Dug or drilled)

diameter 8 inches. Elevation of ground at well site _____ feet, mean sea level.

15 inches above L.S.D.

(As near as known)

Depth to water table _____ feet.

7. Capacity of Well: 30 g.p.m. with 32 feet drawdown:

_____ g.p.m. with _____ feet drawdown.

Date of test March 20, 1953

stands 15" above L.S.D.

If Flowing Well: Measured discharge 5 g.p.m. on 3/20/53

(Date)

Shut-in pressure at ground surface _____ lbs. per sq. in. on _____


(Date)

Water is controlled by Cap

(Cap, valve, etc.)

Drawing attached

Township 15 Range 2W, W.M.
North

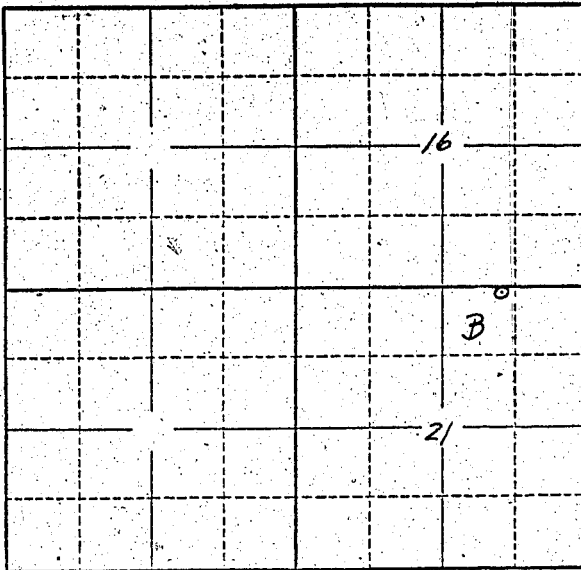

Locate well and acreage of irrigated land on plat.
Scale: 2" = 1 Mile

STATE OF OREGON

County of _____ } ss.

We Emmett E. & Amy E. Woodward being first duly sworn, do hereby certify that I have read the foregoing Registration Statement and that all of the items therein contained are true to the best of my knowledge and belief.

Emmett E. Woodward
Amy E. Woodward
(Signature of Registrant)

Subscribed and sworn to before me this 7th day of April, 1958.

My commission expires JULY 21, 1961

Paul B. Conn
(Notary Public)

(SEAL)

CERTIFICATE OF REGISTRATION

STATE OF OREGON

County of Marion } ss.

This is to certify that the foregoing Registration Statement was received in the office of the State Engineer on the 7th day of April, 1958, at 8:00 o'clock A.M. and has been duly recorded in said office in Book No. 11 of Registration Statements on page GR-2539

Witness my hand this 6th day of April, 1959

Laura A. Stanley
(State Engineer)

By _____ (Deputy)

GR-2539

\$15.00