

RECEIVED
APR 7 1958
STATE ENGINEER
SALEM, OREGON

Registration No. GR - 1358
Certificate No. GR - 1313

Registration Statement

OF CLAIMANT OF RIGHT TO APPROPRIATE GROUND WATER

TO THE STATE ENGINEER OF OREGON

Waldemar Christensen
Route 2, Box 449-C
Eugene, Oregon

I, Waldemar Christensen

of Rt. 2 box 449C--Eugene Clatsop County of Lane

State of Oregon, do hereby make application for a certificate of registration as evidence of a right to appropriate ground water.

1. Source from which water is withdrawn is pump well
(Flowing well, pump well, infiltration trench, or tunnel)

2. Location is: 5 miles NW from Coburg, Oregon
(Approximate distance and direction from nearest city or town)

and is more particularly described as follows:

(a) 2256 ft N28° 39' W from the SE corner of Section 11
(Give distance and bearing to corner of section or other legal subdivision)

being within NE¹ of SE¹ of Sec. 11, Twp. 16 Rge. 4 W
(Smallest legal subdivision) (N. or S.) (E. or W.)

or (b) within limits of recorded platted property, town or city:

in Lot _____ Block _____ of _____
(Name of plat or addition)

County of _____
(If within city or town, give name)

3. Construction Work was begun on May 1941; was completed on June 1941
(Date) (Date)

and the ground water claimed was first used for the purposes set out below on June 1941
(Date)

since which time the water has been used intermittently
(Continuously or intermittently)

from 1955 to 1941
(Date) (Date)

4. Quantity of water claimed and used is 350 gallons per minute; 5.50 acre feet per year.

5. Purpose or Purposes for which water is used irrigation

(Domestic, irrigation, municipal, manufacturing, industrial, etc.)

6. Description of Well: Depth 30 feet. Type drilled
(Dug or drilled)

diameter 2 - 4 inches. Elevation of ground at well site 340 feet, mean sea level.
(As near as known)

Depth to water table 10 feet.

7. Capacity of Well: ? g.p.m. with 3 feet drawdown.

350 g.p.m. with 3 feet drawdown.


Date of test _____

If Flowing Well: Measured discharge _____ g.p.m. on _____
(Date)

Shut-in pressure at ground surface _____ lbs. per sq. in. on _____
(Date)

Water is controlled by _____
(Cap, valve, etc.)

Township 16 S Range 4 W W, W.M.
North

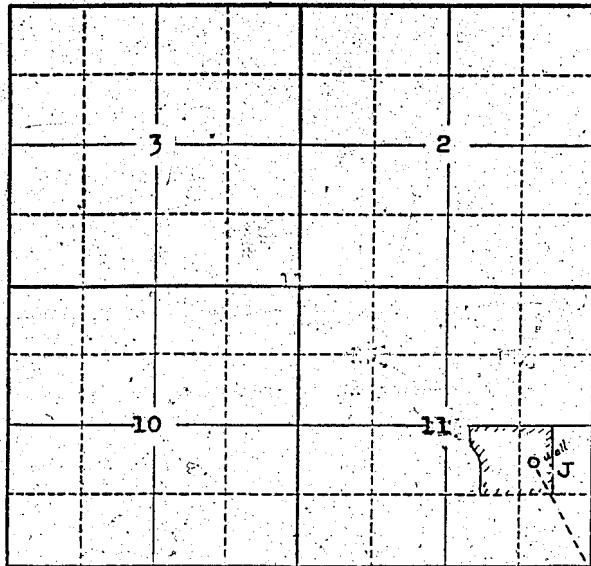

Locate well and acreage of irrigated land on plat.
Scale: 2" = 1 Mile

STATE OF OREGON

County of Linn } ss.

I, Waldemar Christensen, being first duly sworn, do hereby certify that I have read the foregoing Registration Statement and that all of the items therein contained are true to the best of my knowledge and belief.

Waldemar Christensen
(Signature of Registrant)

Subscribed and sworn to before me this 1st day of April, 1958

My commission expires Aug. 10, 1959

Ray John
(Notary Public)

(SEAL)

CERTIFICATE OF REGISTRATION

STATE OF OREGON }
County of Marion } ss.

This is to certify that the foregoing Registration Statement was received in the office of the State Engineer on the 7th day of April, 1958, at 8:00 o'clock A.M. and has been duly recorded in said office in Book No. 6 of Registration Statements on page GR-1313

Witness my hand this 20th day of October, 1958

Lewis A. Stanley
(State Engineer)

By _____
(Deputy)

GR - 1313

#16.35