

RECEIVED
APR 7 1958
STATE ENGINEER
SALEM, OREGON

Registration No. GR. - 1359
Certificate No. GR. - 1314

Registration Statement

OF CLAIMANT OF RIGHT TO APPROPRIATE GROUND WATER

TO THE STATE ENGINEER OF OREGON:

I, ORLANDO A. CUMMINS OR ALICE A. CUMMINS
of 1090 RIVER LOOP #1 Eugene County of Lane
State of Oregon, do hereby make application for a certificate of registration as evidence
of a right to appropriate ground water.

1. Source from which water is withdrawn is PUMP WELL #1
(Flowing well, pump well, infiltration trench, or tunnel)
2. Location is: 6 miles North of Eugene
(Approximate distance and direction from nearest city or town)

and is more particularly described as follows:

(a) 2300ft west & 350ft south N.E. Cor. Sec. 12
(Give distance and bearing to corner of section or other legal subdivision)
being within NW 1/4 of NE 1/4 of Sec. 12, Twp. 12-S, Rge. 4-W
(Smallest legal subdivision) (N. or S.) (E. or W.)

or (b) within limits of recorded platted property, town or city: _____
in Lot _____, Block _____ of _____
(Name of plat or addition)
County of Lane
(If within city or town, give name)

3. Construction Work was begun on 1940; was completed on 1940
(Date) (Date)
and the ground water claimed was first used for the purposes set out below on 1940
(Date)
since which time the water has been used intermittently
(Continuously or Intermittently)
from May 1 1940 to Oct 1 present
(Date) (Date)

4. Quantity of water claimed and used is 180 gallons per minute; 42.5 acre feet per year.

5. Purpose or Purposes for which water is used irrigation
(Domestic, irrigation, municipal, manufacturing, industrial, etc.)

6. Description of Well: Depth 20 feet. Type Drilled
(Dug or drilled)
diameter 4 inch inches. Elevation of ground at well site 325 feet, mean sea level.
(As near as known)
Depth to water table 12 feet.

7. Capacity of Well: _____ g.p.m. with _____ feet drawdown.
_____ g.p.m. with _____ feet drawdown.

Date of test _____
If Flowing Well: Measured discharge _____ g.p.m. on _____
(Date)
Shut-in pressure at ground surface _____ lbs. per sq. in. on _____
(Date)
Water is controlled by _____
(Cap, valve, etc.)

8. Casing: (Give diameter, commercial specifications and depth below ground surface of each casing size.)

4 inch diameter pipe from 0 to 20 feet
..... inch diameter from to feet
..... inch diameter from to feet
..... inch diameter from to feet

Describe and show depth of shoe, plug, adapter, liner or other details:

9. Perforated Casings or Screens:

none from to
(Number per foot and size of perforations, or describe screen)
..... from to
..... from to
..... from to

10. Log of Well: (Describe each stratum or formation clearly, indicate if water bearing, and give thickness and depth as indicated.)

MATERIAL	Thickness (Feet)	Depth to Bottom (Feet)
<u>none</u>		

If log of well is not available, give name and address of driller. Joe Richards former owner

11. Infiltration Trench; Covered or open

Dimensions: Length ft. Minimum depth ft. Maximum depth ft.

Bottom width ft. Discharge g.p.m. Date of test

12. Tunnel: Type of lining

Dimensions:
(Length, course, and cross sectional size)

Position of water bearing stratum with reference to portal of tunnel

Log of tunnel: (Preceding table for log of well may be used, if desired. Give footage from portal and character of materials, as pertinent.)

13. Pumping Equipment:

(a) Pump Franklin Morse Elec. 1 1/2 in Capacity 180 g.p.m.
(Make, type and size)


(b) Motor Electric 7 1/2 H.P. - To be changed to 10 H.P.
(Type and horsepower)

14. Location of area irrigated or to be irrigated, or place of use if for purposes other than irrigation.

Township North or South	Range E. or W. of Willamette Meridian	Section	Forty-acre Tract	Number Acres To Be Irrigated	Date of Reclamation
17-S	4-W	12	NW 1/4 of NE 1/4	17.5	1940

15. If the ground water supply is supplemental to an existing water supply, identification of any application for a permit, permit, certificate or adjudicated right to appropriate water made or held by the registrant.

Township 17S Range 4W, W.M.
North

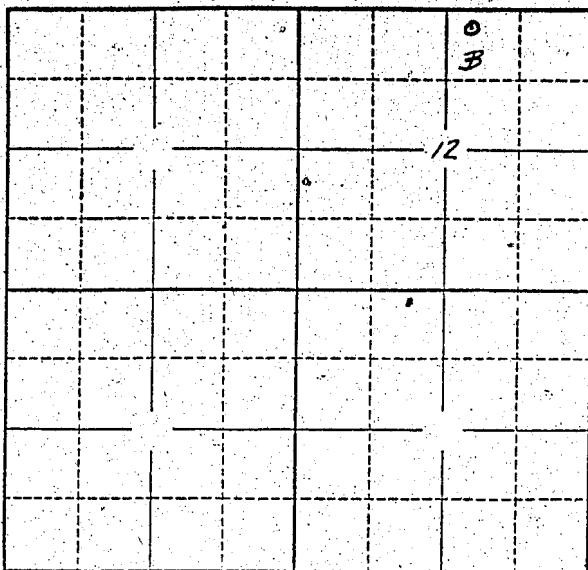

Locate well and acreage of irrigated land on plat.
Scale: 2" = 1 Mile

STATE OF OREGON

County of Marion

} ss.

I, _____, being first duly sworn, do hereby certify that I have read the foregoing Registration Statement and that all of the items therein contained are true to the best of my knowledge and belief.

Orlando A. Cummings
(Signature of Registrant)

Subscribed and sworn to before me this 1st day of April, 1958

My commission expires 12th June 1961

Wm. S. Bartholomew
(Notary Public)

(SEAL)

CERTIFICATE OF REGISTRATION

STATE OF OREGON

County of Marion

} ss.

This is to certify that the foregoing Registration Statement was received in the office of the State Engineer on the 7th day of April, 1958, at 6:00 o'clock A. M. and has been duly recorded in said office in Book No. 6 of Registration Statements on page GR-1314

Witness my hand this 20th day of October, 1958

Lewis A. Stanley
(State Engineer)

By _____

(Deputy)

GR - 1314