

Registration Statement**OF CLAIMANT OF RIGHT TO APPROPRIATE GROUND WATER**

(Under Chapter 708, Oregon Laws 1955.)

TO THE STATE ENGINEER OF OREGON:I, Leo H. Weddleof Jefferson Ore County of LinnState of Oregon, do hereby make application for a certificate of registration as evidence of a right to appropriate ground water.1. Source from which water is withdrawn is PUMP WELL #1
(Flowing well, pump well, infiltration trench, or tunnel)2. Location is: 1/2 Mile West - Jefferson
(Approximate distance and direction from nearest city or town)

and is more particularly described as follows:

(a) DR - 200 feet north and 200 feet west from center of section 11.
8 Chains North and 11 Chains west on Private Road
(Give distance and bearing to corner of section or other legal subdivision)being within Jacob E. Miller SE 1/4 NW 1/4 D.L.C. of Sec. 11, Twp. 10S, Rge. 3 W.
(Smallest legal subdivision) (N. or S.) (E. or W.)

or (b) within limits of recorded platted property, town or city:

in Lot _____, Block _____ of _____
(Name of plat or addition)County of _____
(If within city or town, give name)3. Construction Work was begun on Feb 1940; was completed on same
(Date) (Date)and the ground water claimed was first used for the purposes set out below on May 5 1940
(Date)since which time the water has been used Continuously
(Continuously or intermittently)from May 1940 to Mar 1 1956
(Date) (Date)4. Quantity of water claimed and used is 600 gallons per minute; _____ acre feet per year.5. Purpose or Purposes for which water is used Crop irrigation

(Domestic, irrigation, municipal, manufacturing, industrial, etc.)

6. Description of Well: Depth 20 feet. Type Drilled
(Dug or drilled)diameter 10 inches. Elevation of ground at well site 250 feet, mean sea level.
(As near as known)Depth to water table 8-10 feet.7. Capacity of Well: 600 g.p.m. with 4 feet drawdown.

_____ g.p.m. with _____ feet drawdown.

Date of test _____

If Flowing Well: Measured discharge _____ g.p.m. on _____
(Date)Shut-in pressure at ground surface _____ lbs. per sq. in. on _____
(Date)Water is controlled by _____
(Cap, valve, etc.)Well No. - 1

8. Casing: (Give diameter, commercial specifications and depth below ground surface of each casing size.)

10" inch diameter from 0 to 20 feet

..... inch diameter from to feet

..... inch diameter from to feet

..... inch diameter from to feet

Describe and show depth of shoe, plug, adapter, liner or other details:

9. Perforated Casings or Screens:

5/16" from to
(Number per foot and size of perforations, or describe screen)

..... from to

..... from to

..... from to

10. Log of Well: (Describe each stratum or formation clearly, indicate if water bearing, and give thickness and depth as indicated.)

MATERIAL	Thickness (Feet)	Depth to Bottom (Feet)
Sandy loam	9 -	
Medium to Coarse Gravel	11 -	20 ft

If log of well is not available, give name and address of driller.

11. Infiltration Trench: Covered or open

Dimensions: Length ft. Minimum depth ft. Maximum depth ft.
 Bottom width ft. Discharge g.p.m. Date of test

12. Tunnel: Type of lining

Dimensions:
(Length, course, and cross sectional size)
 Position of water bearing stratum with reference to portal of tunnel

Log of tunnel: (Preceding table for log of well may be used, if desired. Give footage from portal and character of materials, as pertinent.)

13. Pumping Equipment:


(a) Pump *Pacific Centrifical - 4" by 3"* Capacity *650* g.p.m.
(Make, type and size)
 (b) Motor *GE 20 H.P.*
(Type and horsepower)

14. Location of area irrigated or to be irrigated, or place of use if for purposes other than irrigation.

Township North or South	Range E. or W. of Willamette Meridian	Section	Forty-acre Tract	Number Acres To Be Irrigated	Date of Reclamation
10 S	3 W	11	NE $\frac{1}{4}$ of SW $\frac{1}{4}$	45 30	5/5/40
"	"	"	SE $\frac{1}{4}$ of NW $\frac{1}{4}$	9	"
"	"	"	SW $\frac{1}{4}$ of NE $\frac{1}{4}$	3	"
"	"	"	NW $\frac{1}{4}$ of SE $\frac{1}{4}$	3	"
				45	

15. If the ground water supply is supplemental to an existing water supply, identification of any application for a permit, permit, certificate or adjudicated right to appropriate water made or held by the registrant.

Township 10S Range 3W, W.M.
North

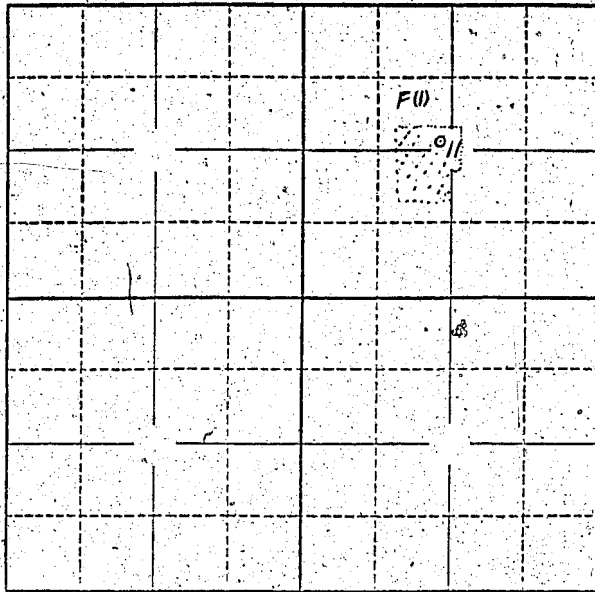

Locate well and acreage of irrigated land on plat.
Scale: 2" = 1 Mile

STATE OF OREGON

County of Marion } ss.

I, Leo A. Wedale, being first duly sworn, do hereby certify that I have read the foregoing Registration Statement and that all of the items therein contained are true to the best of my knowledge and belief.

Leo A. Wedale
(Signature of Registrant)

Subscribed and sworn to before me this 5th day of March, 1956.

My commission expires Sept. 5, 1956 Robert White
(Notary Public)

(SEAL)

CERTIFICATE OF REGISTRATION

STATE OF OREGON

County of Marion } ss. For certificate of registration see page GR-126 W.

~~This is to certify that the foregoing Registration Statement was created in the office of the State Engineer on the _____ of _____, 19____ and has been duly recorded and affixed to Book No. _____ of Registration Statements on page _____ Construction shall be completed by _____ and the water completely applied to beneficial use by _____.~~

Witness my hand this _____ day of _____, 19____.

(State Engineer)

By _____
(Deputy)

Registration Statement

OF CLAIMANT OF RIGHT TO APPROPRIATE GROUND WATER

(Under Chapter 708, Oregon Laws 1955.)

TO THE STATE ENGINEER OF OREGON:

I, Leo A. Weddle
of Jefferson County of Linn

State of Oregon, do hereby make application for a certificate of registration as evidence of a right to appropriate ground water.

1. Source from which water is withdrawn is Pump Well #2
(Flowing well, pump well, infiltration trench, or tunnel)

2. Location is: 1/2 mile west of Jefferson
(Approximate distance and direction from nearest city or town)

and is more particularly described as follows:

(a) 800 feet north and 130 feet east from center of section 11.
12 Chinas North Pump No. One
SW 1/4 of NE 1/4 (Give distance and bearing to corner of section or other legal subdivision)

being within Miller D.C. of Sec. 11, Twp. 10S, Rge. 3W
(Smallest legal subdivision) (N. or S.) (E. or W.)

or (b) within limits of recorded platted property, town or city:

in Lot _____ Block _____ of _____
(Name of plat or addition)

County of _____
(If within city or town, give name)

3. Construction Work was begun on March 43; was completed on March 43
(Date) (Date)

and the ground water claimed was first used for the purposes set out below on May 43
(Date)

since which time the water has been used Continuously
(Continuously or intermittently)

from May 43 to Sept 55
(Date) (Date)

4. Quantity of water claimed and used is 300 gallons per minute; _____ acre feet per year.

5. Purpose or Purposes for which water is used Crop irrigation

(Domestic, irrigation, municipal, manufacturing, industrial, etc.)

6. Description of Well: Depth 20 feet. Type Drilled
(Dug or drilled)

diameter 10 inches. Elevation of ground at well site 220 feet, mean sea level.
(As near as known)

Depth to water table 8-10 feet.

7. Capacity of Well: 400 g.p.m. with 6 feet drawdown.

_____ g.p.m. with _____ feet drawdown.

Date of test _____

If Flowing Well: Measured discharge _____ g.p.m. on _____
(Date)

Shut-in pressure at ground surface _____ lbs. per sq. in. on _____
(Date)

Water is controlled by _____
(Cnp, valve, etc.)

Well No. 2

GR-126 D

8. **Casing:** (Give diameter, commercial specifications and depth below ground surface of each casing size.)

10 inch diameter from 0 to 20 feet
 inch diameter from to feet
 inch diameter from to feet
 inch diameter from to feet

Describe and show depth of shoe, plug, adapter, liner or other details:

9. **Perforated Casings or Screens:**

NONE from to
 (Number per foot and size of perforations, or describe screen)
 from to
 from to
 from to

10. **Log of Well:** (Describe each stratum or formation clearly, indicate if water bearing, and give thickness and depth as indicated.)

MATERIAL	Thickness (Feet)	Depth to Bottom (Feet)
Sandy loam - Medium to Coarse Gravel	10 - 10	20 ft.

If log of well is not available, give name and address of driller.

11. Infiltration Trench: Covered or open

Dimensions: Length ft. Minimum depth ft. Maximum depth ft.

Bottom width ft. Discharge g.p.m. Date of test

12. Tunnel: Type of lining

Dimensions:
(Length, course, and cross sectional size)

Position of water bearing stratum with reference to portal of tunnel

Log of tunnel: (Preceding table for log of well may be used, if desired. Give footage from portal and character of materials, as pertinent.)

13. Pumping Equipment:

(a) Pump Pacific - Centrifugal 4-3 Capacity 350 g.p.m.
(Make, type and size)


(b) Motor 15 H.P.
(Type and horsepower)

14. Location of area irrigated or to be irrigated, or place of use if for purposes other than irrigation.

Township North or South	Range E. or W. of Willamette Meridian	Section	Forty-acre Tract	Number Acres To Be Irrigated	Date of Reclamation
T10.5	3. W	11		27 ^{Total} Acres	5/43
"	"	"	SE 1/4 of NW 1/4	20	
"	"	"	SW 1/4 of NE 1/4	7	
				27	

15. If the ground water supply is supplemental to an existing water supply, identification of any application for a permit, permit, certificate or adjudicated right to appropriate water made or held by the registrant.

Township 10 S Range 3 W, W.M.
North

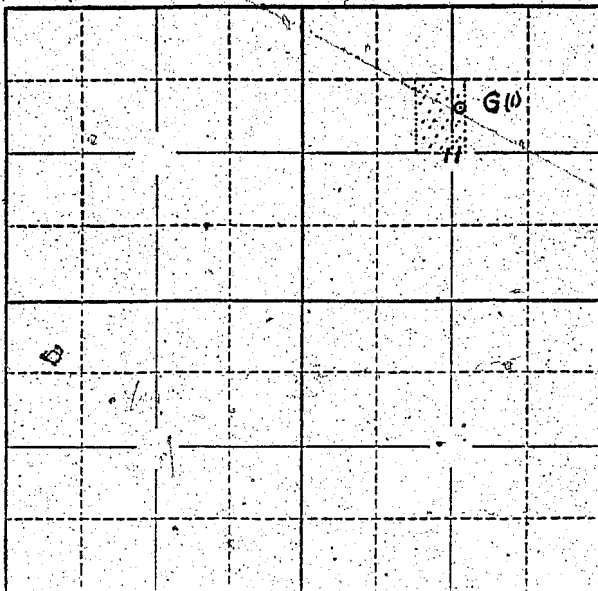

Locate well and acreage of irrigated land on plat.

Scale: 2" = 1 Mile

STATE OF OREGON

County of Marion } ss.

I, Lee H. Weddle, being first duly sworn, do hereby certify that I have read the foregoing Registration Statement and that all of the items therein contained are true to the best of my knowledge and belief.

Lee Weddle
(Signature of Registrant)

Subscribed and sworn to before me this 1st day of March, 1956.

My commission expires Sept 15 1956

Robert Wilson
(Notary Public)

(SEAL)

CERTIFICATE OF REGISTRATION

STATE OF OREGON

County of Marion } ss. For certificate of registration see page GR-126 W.

~~This is to certify that the foregoing Registration Statement was received in the office of the State Engineer on the _____ day of _____, 19____ and has been duly recorded in said office in Book No. _____ of Registration Statements on page _____.~~
~~Construction shall be complete by _____, 19____ and the water completely applied to beneficial use by _____, 19____.~~

~~Witness my hand this _____ day of _____, 19____.~~

.....
(State Engineer)

By
(Deputy)

GR-126 G

Registration Statement

OF CLAIMANT OF RIGHT TO APPROPRIATE GROUND WATER

(Under Chapter 708, Oregon Laws 1955.)

TO THE STATE ENGINEER OF OREGON:

I, L. A. Waddle
of Jefferson Oregon County of Linn
State of Oregon, do hereby make application for a certificate of registration as evidence
of a right to appropriate ground water.

1. Source from which water is withdrawn is Pump Well
(Flowing well, pump well, infiltration trench, or tunnel)

2. Location is: 1/2 mile west of Jefferson
(Approximate distance and direction from nearest city or town)

and is more particularly described as follows:

(a) 900 feet north and 300 feet east from W 1/4 corner section 4
17 chains south iron pipe corner
(Give distance and bearing to corner of section or other legal subdivision)

being within Jacob L. Miller D.C. of Sec. 11 Twp. 10 S Rge. 30
(Smallest legal subdivision) (N. or S.) (E. or W.)

or (b) within limits of recorded platted property, town or city:

in Lot _____, Block _____ of _____
(Name of plat or addition)

County of _____
(If within city or town, give name)

3. Construction Work was begun on March - 1941 was completed on March - 1941
(Date) (Date)

and the ground water claimed was first used for the purposes set out below on June - 1941
(Date)

since which time the water has been used continuously
(Continuously or intermittently)

from June - 1941 to Sept - 1941
(Date) (Date)

4. Quantity of water claimed and used is 300 gallons per minute; _____ acre
feet per year.

5. Purpose or Purposes for which water is used crop irrigation

(Domestic, irrigation, municipal, manufacturing, industrial, etc.)

6. Description of Well: Depth 25 feet. Type Drilled
(Dug or drilled)

diameter 10 inches. Elevation of ground at well site 250 220 feet, mean sea level.
(As near as known)

Depth to water table 8-10 feet.

7. Capacity of Well: 450 g.p.m. with 5 feet drawdown.

_____ g.p.m. with _____ feet drawdown.

Date of test _____

If Flowing Well: Measured discharge _____ g.p.m. on _____
(Date)

Shut-in pressure at ground surface _____ lbs. per sq. in. on _____
(Date)

Water is controlled by _____
(Cap, valve, etc.)

GR-126 H

Well No. - 3

8. Casing: (Give diameter, commercial specifications and depth below ground surface of each casing size.)

10 inch diameter from 0 to 25 feet
 inch diameter from to feet
 inch diameter from to feet
 inch diameter from to feet

Describe and show depth of shoe, plug, adapter, liner or other details:

9. Perforated Casings or Screens:

..... from to
(Number per foot and size of perforations, or describe screen)
 from to
 from to
 from to

10. Log of Well: (Describe each stratum or formation clearly, indicate if water bearing, and give thickness and depth as indicated.)

MATERIAL	Thickness (Feet)	Depth to Bottom (Feet)
Sandy Loam	10	
Medium coarse gravel	15	25

If log of well is not available, give name and address of driller.

11. Infiltration Trench: Covered or open

Dimensions: Length ft. Minimum depth ft. Maximum depth ft.
Bottom width ft. Discharge g.p.m. Date of test

12. Tunnel: Type of lining

Dimensions:
(Length, course, and cross sectional size)
Position of water bearing stratum with reference to portal of tunnel

Log of tunnel: (Preceding table for log of well may be used, if desired. Give footage from portal and character of materials, as pertinent.)

13. Pumping Equipment:

(a) Pump *Allis-Chalmers - Centrifugal - 3x3* Capacity *330* g.p.m.
(Make, type and size)
(b) Motor *Allis Chalmers - 15 H.P.*
(Type and horsepower)


14. Location of area irrigated or to be irrigated, or place of use if for purposes other than irrigation.

Township North or South	Range E. or W. of Willamette Meridian	Section	Forty-acre Tract	Number Acres To Be Irrigated	Date of Reclamation
<i>10 S</i>	<i>3W</i>	<i>11</i>		<i>30 acres</i>	<i>6/1941</i>
<i>"</i>	<i>"</i>	<i>10</i>	<i>SE 1/4 of NE 1/4</i>	<i>15</i>	<i>"</i>
<i>"</i>	<i>"</i>	<i>11</i>	<i>SW 1/4 of NW 1/4</i>	<i>15</i>	

15. If the ground water supply is supplemental to an existing water supply, identification of any application for a permit, permit, certificate or adjudicated right to appropriate water made or held by the registrant.

Township 10.5 Range 3W W.M.

North

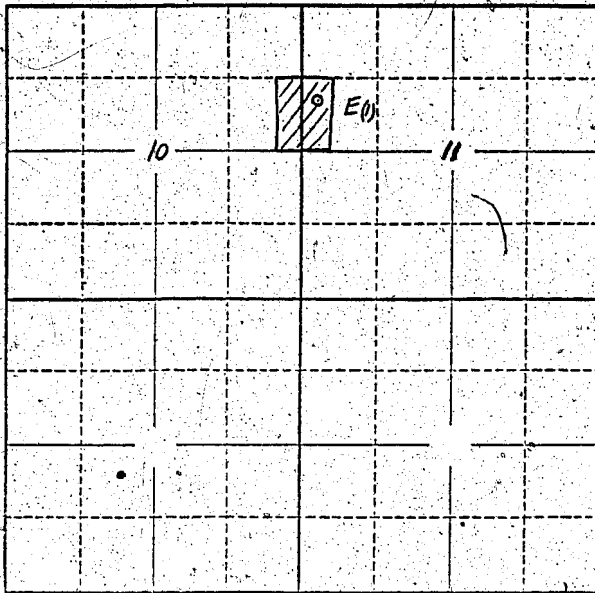

Locate well and acreage of irrigated land on plat.

Scale: 2" = 1 Mile

STATE OF OREGON


I, Les A. Waddle, being first duly sworn, do hereby certify that I have read the foregoing Registration Statement and that all of the items therein contained are true to the best of my knowledge and belief.

Les A. Waddle
(Signature of Registrant)


(Notary Public)

(SEAL)

CERTIFICATE OF REGISTRATION

For certificate of registration see page GR-126 W.

STATE OF OREGON

County of Marion } ss.




(State Engineer)

By _____ (Deputy)

GR-126 K

Registration Statement

OF CLAIMANT OF RIGHT TO APPROPRIATE GROUND WATER

(Under Chapter 708, Oregon Laws 1955.)

TO THE STATE ENGINEER OF OREGON:

I, Leo A Weddle

of Jefferson County of Lin

State of Oregon, do hereby make application for a certificate of registration as evidence of a right to appropriate ground water.

1. Source from which water is withdrawn is PUMP WELL
(Flowing well, pump well, infiltration trench, or tunnel)

2. Location is: 1/4 Mile West - Jefferson
(Approximate distance and direction from nearest city or town)

and is more particularly described as follows:

(a) 650 feet east and 290 feet north from center section 11
6 Chains East of Private Road

being within SW 1/4 of NE 1/4 (Give distance and bearing to corner of section or other legal subdivision)
Jacob Miller D.L.C. of Sec. 11, Twp. 10-S Rge. 3-W
(Smallest legal subdivision) (N. or S.) (E. or W.)

or (b) within limits of recorded platted property, town or city:

in Lot _____ Block _____ of _____
(Name of plat or addition)

County of _____
(If within city or town, give name)

3. Construction Work was begun on April '44; was completed on April '44
(Date) (Date)

and the ground water claimed was first used for the purposes set out below on May 15 '44
(Date)

since which time the water has been used Continuously
(Continuously or Intermittently)

from May 15 '44 to Nov 1 '58
(Date) (Date)

4. Quantity of water claimed and used is 400 gallons per minute; _____ acre feet per year.

5. Purpose or Purposes for which water is used Irrigation
(Domestic, irrigation, municipal, manufacturing, industrial, etc.)

6. Description of Well: Depth 20 feet. Type Drilled
(Dug or drilled)

diameter 12" inches. Elevation of ground at well site 220 feet, mean sea level.
(As near as known)

Depth to water table 8 1/2 feet.

7. Capacity of Well: 580 g.p.m. with 6 feet drawdown.

_____ g.p.m. with _____ feet drawdown.

Date of test April 44

If Flowing Well: Measured discharge _____ g.p.m. on _____
(Date)

Shut-in pressure at ground surface _____ lbs. per sq. in. on _____
(Date)

Water is controlled by _____
(Cap. valve, etc.)

Well No. 4 -

8. Casing: (Give diameter, commercial specifications and depth below ground surface of each casing size.)

10" inch diameter from 0 to 20 feet
 inch diameter from to feet
 inch diameter from to feet
 inch diameter from to feet

Describe and show depth of shoe, plug, adapter, liner or other details:

9. Perforated Casings or Screens:

NONE from to
(Number per foot and size of perforations, or describe screen)
 from to
 from to
 from to

10. Log of Well: (Describe each stratum or formation clearly, indicate if water bearing, and give thickness and depth as indicated.)

MATERIAL	Thickness (Feet)	Depth to Bottom (Feet)
Sandy loam -	6 ft	
Coarse Gravel -	14 ft	20 ft

If log of well is not available, give name and address of driller.

11. Infiltration Trench: Covered or open

Dimensions: Length ft. Minimum depth ft. Maximum depth ft.

Bottom width ft. Discharge g.p.m. Date of test

12. Tunnel: Type of lining

Dimensions:
(Length, course, and cross sectional size)

Position of water bearing stratum with reference to portal of tunnel

Log of tunnel: (Preceding table for log of well may be used, if desired. Give footage from portal and character of materials, as pertinent.)

13. Pumping Equipment:

(a) Pump *Berkley centrifical 20 H.P. 4 x 3* Capacity *450* g.p.m.
(Make, type and size)


(b) Motor *20 H.P. 7 Morse*
(Type and horsepower)

14. Location of area irrigated or to be irrigated, or place of use if for purposes other than irrigation.

Township North or South	Range E. or W. of Willamette Meridian	Section	Forty-acre Tract	Number Acres To Be Irrigated	Date of Reclamation
10 S	3-10	11	-	40	4/1944
"	"	"	SW 1/4 NE 1/4	30	"
"	"	"	NE 1/4 of SE 1/4	10	"

15. If the ground water supply is supplemental to an existing water supply, identification of any application for a permit, permit, certificate or adjudicated right to appropriate water made or held by the registrant.

Township 10 Range 3W, W.M.
North

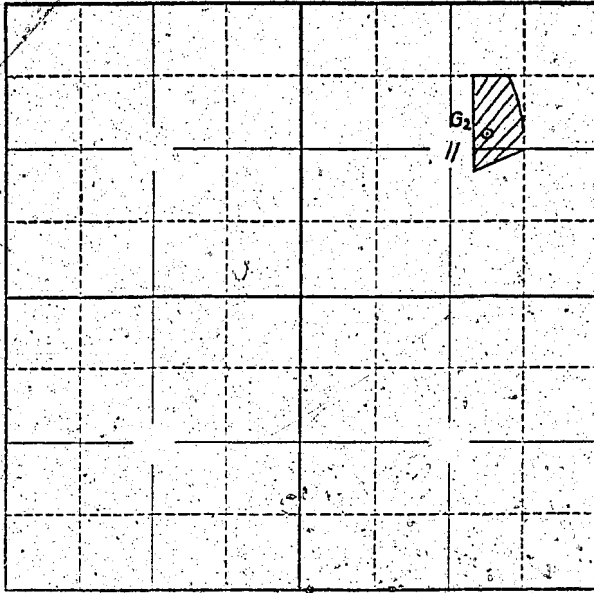

Locate well and acreage of irrigated land on plat.
Scale: 2" = 1 Mile

STATE OF OREGON

County of Marion } ss.

I, Les. H. Waddle, being first duly sworn, do hereby certify that I have read the foregoing Registration Statement and that all of the items therein contained are true to the best of my knowledge and belief.

Les. H. Waddle

(Signature of Registrant)

Subscribed and sworn to before me this 11 day of Nov, 1956.

My commission expires Dec 1 5 1956

(Notary Public)

(SEAL)

CERTIFICATE OF REGISTRATION

For certificate of registration see page GR-126 W

STATE OF OREGON

County of Marion } ss.

~~This is to certify that the foregoing Registration Statement was received in the office of the State Engineer on the _____ day of _____ 19____ and that _____ Member has been duly recorded in said office in Book No. _____ of Registration Statements on page _____~~

~~Construction shall be completed by _____ 19____ and this water completely applied for _____~~

~~Witness my hand this _____ day of _____ 19____~~

(State Engineer)

By _____ (Deputy)

Registration Statement

OF CLAIMANT OF RIGHT TO APPROPRIATE GROUND WATER

(Under Chapter 708, Oregon Laws 1955.)

TO THE STATE ENGINEER OF OREGON:

I, Leo A. Weddle

of Jefferson County of Linn

State of Oregon, do hereby make application for a certificate of registration as evidence of a right to appropriate ground water.

1. Source from which water is withdrawn is Pump Well
(Flowing well, pump well, infiltration trench, or tunnel)

2. Location is: 3/4 Mile West of Jefferson
(Approximate distance and direction from nearest city or town)

and is more particularly described as follows:

(a) 1050 feet south and 1650 feet east from NW 1/4 corner section 11.
5 Chains South 20 Chains East Iron Pipe Marker
(Give distance and bearing to corner of section or other legal subdivision)

being within Jacob L. Miller D.C. of Sec. 11, Twp. 10-S, Rge. 3-W
(Smallest legal subdivision) (N. or S.) (E. or W.)

or (b) within limits of recorded platted property, town or city:

in Lot _____, Block _____ of _____
(Name of plat or addition)

County of _____
(If within city or town, give name)

3. Construction Work was begun on Oct '52; was completed on Oct '52
(Date) (Date)

and the ground water claimed was first used for the purposes set out below on April '53
(Date)

since which time the water has been used Continuously
(Continuously or Intermittently)

from April '53 to Sept '55
(Date) (Date)

4. Quantity of water claimed and used is 325 gallons per minute; _____ acre feet per year.

5. Purpose or Purposes for which water is used Crop irrigation

(Domestic, irrigation, municipal, manufacturing, industrial, etc.)

6. Description of Well: Depth 20 feet. Type Drilled
(Dug or drilled)

diameter 10 inches. Elevation of ground at well site 250 220 feet, mean sea level.
(As near as known)

Depth to water table 4-6 feet.

7. Capacity of Well: 250 g.p.m. with 0-2 feet drawdown.

_____ g.p.m. with _____ feet drawdown.

Date of test _____

If Flowing Well: Measured discharge _____ g.p.m. on _____
(Date)

Shut-in pressure at ground surface _____ lbs. per sq. in. on _____
(Date)

Water is controlled by _____
(Cap, valve, etc.)

Well No. 5

8. Casing: (Give diameter, commercial specifications and depth below ground surface of each casing size.)

10 inch diameter from 0 to 20 feet
..... inch diameter from to feet
..... inch diameter from to feet
..... inch diameter from to feet

Describe and show depth of shoe, plug, adapter, liner or other details:

9. Perforated Casings or Screens:

..... from to
(Number per foot and size of perforations, or describe screen)
..... from to
..... from to
..... from to

10. Log of Well: (Describe each stratum or formation clearly, indicate if water bearing, and give thickness and depth as indicated.)

MATERIAL	Thickness (Feet)	Depth to Bottom (Feet)
Sandy Loam to Coarse Gravel	14-6	20 ft.

If log of well is not available, give name and address of driller.

11. Infiltration Trench Covered or open
 Dimensions: Length ft. Minimum depth ft. Maximum depth ft.
 Bottom width ft. Discharge g.p.m. Date of test

12. Tunnel: Type of lining
 Dimensions:
(Length, course, and cross sectional size)
 Position of water bearing stratum with reference to portal of tunnel

Log of tunnel: (Preceding table for log of well may be used, if desired. Give footage from portal and character of materials, as pertinent.)


13. Pumping Equipment:
 (a) Pump Allis-Chalmers - Centrifugal 3-3 Capacity 330 g.p.m.
(Make, type and size)
 (b) Motor Allis-Chalmers 15 H.P.
(Type and horsepower)

14. Location of area irrigated or to be irrigated, or place of use if for purposes other than irrigation.

Township North or South	Range E. or W. of Willamette Meridian	Section	Forty-acre Tract	Number Acres To Be Irrigated	Date of Reclamation
10 S	3 W	11		40 Acres	
"	"	"	NE 1/4 of NW 1/4	25	4/1953
"	"	"	NW 1/4 of NE 1/4	15	"

15. If the ground water supply is supplemental to an existing water supply, identification of any application for a permit, permit, certificate or adjudicated right to appropriate water made or held by the registrant.

Township 10 S Range 3 W W.M.
North

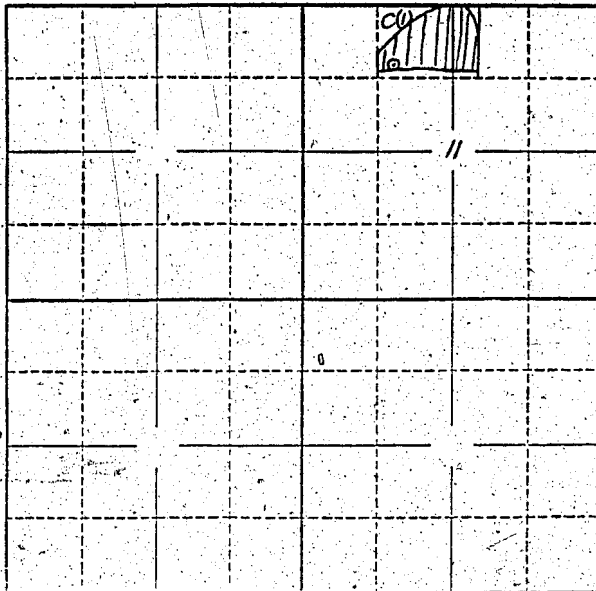

Locate well and acreage of irrigated land on plat.
Scale: 2" = 1 Mile

STATE OF OREGON

County of Marion } ss.

I, Lee A. Waddle, being first duly sworn, do hereby certify that I have read the foregoing Registration Statement and that all of the items therein contained are true to the best of my knowledge and belief.

(Signature of Registrant)

Subscribed and sworn to before me this 1st day of April, 1956

My commission expires Sept 9, 1956

(Notary Public)

(SEAL)

CERTIFICATE OF REGISTRATION

For certificate of registration see page GR-126 W.

STATE OF OREGON

County of Marion } ss.

~~This is to certify that the foregoing Registration Statement was received in the office of the State Engineer on the _____ day of _____, 19____ and that the same has been duly recorded in the office of the State Engineer at _____ of Registration Statements on page _____~~

~~Construction shall be completed by _____, 19____ and the water supply shall be applied to heretofore by _____~~

~~Witness my hand this _____ day of _____, 19____.~~

(State Engineer)

By _____ (Deputy)

GR-126 S

Registration Statement

OF CLAIMANT OF RIGHT TO APPROPRIATE GROUND WATER

(Under Chapter 708, Oregon Laws 1955.)

TO THE STATE ENGINEER OF OREGON:

I, Leo A. Weddke

of Jefferson, Oreg. County of Linn

State of Oregon, do hereby make application for a certificate of registration as evidence of a right to appropriate ground water.

1. Source from which water is withdrawn is Pump Well
(Flowing well, pump well, infiltration trench, or tunnel)

2. Location is: 30 chains west of Pump No 5
(Approximate distance and direction from nearest city or town)

and is more particularly described as follows:

(a) 1150 feet north and 560 feet west from west 1/4 corner of section 11, 1 mile west by north, Jefferson
(Give distance and bearing to corner of section or other legal subdivision)

being within Jacob Miller D.R.S. of Sec. 10, Twp 10-S, Rge. 3-W
(Smallest legal subdivision) (N. or S.) (E. or W.)

or (b) within limits of recorded platted property, town or city:

in Lot _____ Block _____ of _____
(Name of plat or addition)

County of _____
(If within city or town, give name)

3. Construction Work was begun on May 55; was completed on _____
(Date) (Date)

and the ground water claimed was first used for the purposes set out below on June 55
(Date)

since which time the water has been used Continuously
(Continuously or intermittently)

from _____ to Mar 1-56
(Date) (Date)

4. Quantity of water claimed and used is 325 gallons per minute; _____ acre feet per year.

5. Purpose or Purposes for which water is used Crop Irrigation

(Domestic, irrigation, municipal, manufacturing, industrial, etc.)

6. Description of Well: Depth 15 feet. Type Dug
(Dug or drilled)
diameter 10 inches. Elevation of ground at well site 290 feet, mean sea level.
(As near as known)
Depth to water table 4 feet.

7. Capacity of Well: 500 g.p.m. with 2 feet drawdown.
_____ g.p.m. with _____ feet drawdown.

Date of test _____

If Flowing Well: Measured discharge _____ g.p.m. on _____
(Date)

Shut-in pressure at ground surface _____ lbs. per sq. in. on _____
(Date)

Water is controlled by _____
(Cap, valve, etc.)

Well No 6 -

GR-126 T

8. Casing: (Give diameter, commercial specifications and depth below ground surface of each casing size.)

1.0" inch diameter from 0 to 15 feet
 inch diameter from to feet
 inch diameter from to feet
 inch diameter from to feet

Describe and show depth of shoe, plug, adapter, liner or other details:

9. Perforated Casings or Screens:

none

(Number per foot and size of perforations, or describe screen)

..... from to
 from to
 from to
 from to

10. Log of Well: (Describe each stratum or formation clearly, indicate if water bearing, and give thickness and depth as indicated.)

MATERIAL	Thickness (Feet)	Depth to Bottom (Feet)
Sandy loam	6 ft.	15 ft.
Coarse Gravel	9 ft.	

If log of well is not available, give name and address of driller.

11. Infiltration Trench: Covered or open

Dimensions: Length ft. Minimum depth ft. Maximum depth ft.

Bottom width ft. Discharge g.p.m. Date of test

12. Tunnel: Type of lining

Dimensions:
(Length, course, and cross sectional size)

Position of water bearing stratum with reference to portal of tunnel

Log of tunnel: (Preceding table for log of well may be used, if desired. Give footage from portal and character of materials, as pertinent.)

13. Pumping Equipment:

(a) Pump Pacific - centrifugal 4x3 Capacity 450 g.p.m.
(Make, type and size)


(b) Motor GE 15 HP
(Type and horsepower)

14. Location of area irrigated or to be irrigated, or place of use if for purposes other than irrigation.

Township North or South	Range E. or W. of Willamette Meridian	Section	Forty-acre Tract	Number Acres To Be Irrigated	Date of Reclamation
10S	3-6	10	-	44 - 50	5/1955
"	"	10	SE 1/4 of NE 1/4	25	"
"	"	10	NE 1/4 of NE 1/4	25	"

15. If the ground water supply is supplemental to an existing water supply, identification of any application for a permit, permit, certificate or adjudicated right to appropriate water made or held by the registrant.

Township 10S Range 3W, W.M.
North

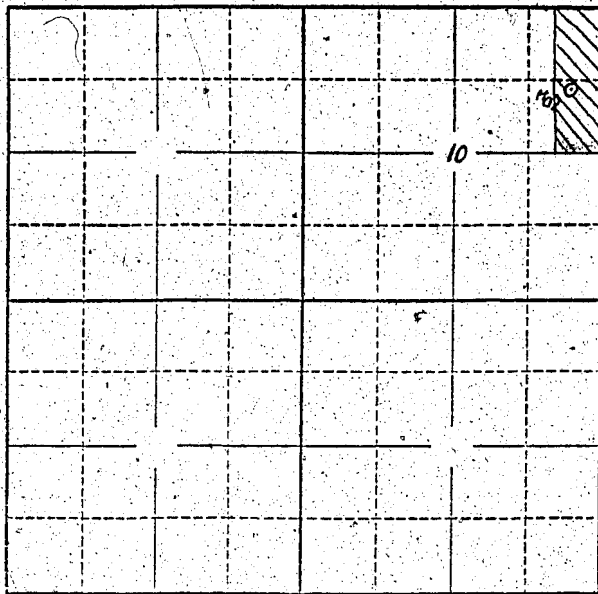

Locate well and acreage of irrigated land on plat.
Scale: 2" = 1 Mile

STATE OF OREGON

County of Linn Marion } ss.

I, Leo F. Waddle, being first duly sworn, do hereby certify that I have read the foregoing Registration Statement and that all of the items therein contained are true to the best of my knowledge and belief.

Leo F. Waddle
(Signature of Registrant)

Subscribed and sworn to before me this 1st day of March, 1956.

My commission expires September 1956 Walter J. Stanley
(Notary Public)

(SEAL)

CERTIFICATE OF REGISTRATION

STATE OF OREGON

County of Marion } ss.

This is to certify that the foregoing Registration Statement was received in the office of the State Engineer on the 1st day of March, 1956, at 11:00 o'clock A. M. and has been duly recorded in said office in Book No. 1 of Registration Statements on page GR-126W.

~~Construction shall be completed by 1956 and the water completely applied by 1956.~~

Witness my hand this 12th day of April, 1956.

Lewis A. Stanley
(State Engineer)

By _____ (Deputy)