

Registration Statement

OF CLAIMANT OF RIGHT TO APPROPRIATE GROUND WATER

TO THE STATE ENGINEER OF OREGON:

I, G. E. Fjarli

of 4017 Jacksonville Highway, Medford County of Jackson
(Mailing address)

State of Oregon, do hereby make application for a certificate of registration as evidence of a right to appropriate ground water.

1. Source from which water is withdrawn is Sump (infiltration trench)
(Flowing well, pump well, infiltration trench, or tunnel)
2. Location is: 3 1/2 miles west of Medford, Oregon
(Approximate distance and direction from nearest city or town)

and is more particularly described as follows:

- (a) 438 feet South and 670 feet west from the NE corner DLC #93
(Give distance and bearing to corner of section or other legal subdivision)
 being within SE 1/4 NE 1/4 SE 1/4 of Sec. 28, Twp. 37 S., Rge. 2 W.
(Smallest legal subdivision) (N. or S.) (E. or W.)
- or (b) within limits of recorded platted property, town or city: _____
 in Lot _____, Block _____ of _____
(Name of plat or addition)

County of _____
(If within city or town, give name)

3. Construction Work was begun on 1947; was completed on 1947
(Date) (Date)

and the ground water claimed was first used for the purposes set-out below on 1948
(Date)

since which time the water has been used intermittently
(Continuously or intermittently)

from 1948 to date
(Date) (Date)

4. Quantity of water claimed and used is 130 gallons per minute; 52 acre feet per year.

5. Purpose or Purposes for which water is used irrigation

(Domestic, irrigation, municipal, manufacturing, industrial, etc.)

See Item E1 Description of Well: Depth 10 feet. Type dug
(Dug or drilled)

diameter 23 x 100 ~~holes~~ Elevation of ground at well site 1412 feet, mean sea level.
(As near as known)

Depth to water table 3.0 feet.

7. Capacity of Well: 200 g.p.m. with 10 feet drawdown.

_____ g.p.m. with _____ feet drawdown.


Date of test none-noted from use

If Flowing Well: Measured discharge _____ g.p.m. on _____
(Date)

Shut-in pressure at ground surface _____ lbs. per sq. in. on _____
(Date)

Water is controlled by _____
(Cap. valve, etc.)

Township 37 S. Range 2 W., W.M.
North

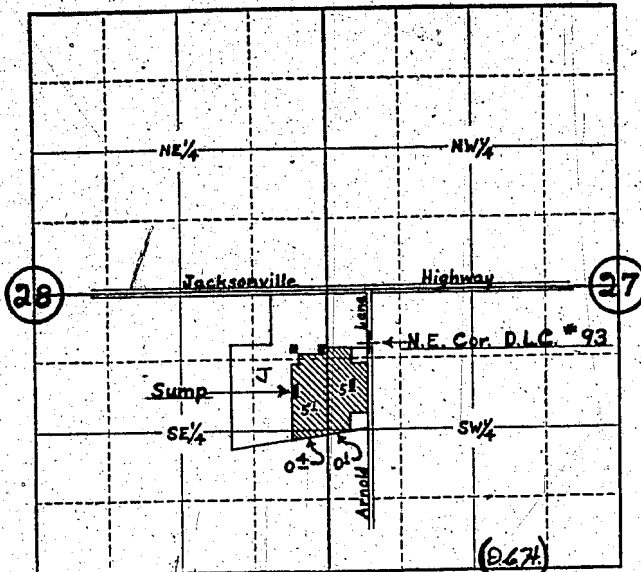

Locate well and acreage of irrigated land on plat.
Scale: 4" = 1 Mile

STATE OF OREGON

County of Jackson } ss.

I, G. E. Farli, being first duly sworn, do hereby certify that I have read the foregoing Registration Statement and that all of the items therein contained are true to the best of my knowledge and belief.

G. E. Farli
(Signature of Registrant)

Subscribed and sworn to before me this 4th day of April, 19 58

My commission expires August 25, 1958

Ralph O. Funderburk
(Notary Public)

(SEAL)

CERTIFICATE OF REGISTRATION

STATE OF OREGON

County of Marion } ss.

This is to certify that the foregoing Registration Statement was received in the office of the State Engineer on the 7th day of April, 19 58, at 8:00 o'clock A. M. and has been duly recorded in said office in Book No. 6 of Registration Statements on page GR-1316

Witness my hand this 20th day of October, 19 58

Lewis A. Stanley
(State Engineer)

By _____ (Deputy)

\$15.00

GR-1316