

RECEIVED
APR 7 1958
STATE ENGINEER
SALEM, OREGON

Registration No. GR. - 1362

Certificate No. GR. - 1317

Registration Statement

OF CLAIMANT OF RIGHT TO APPROPRIATE GROUND WATER

TO THE STATE ENGINEER OF OREGON:

I, Fred. T. Mendenhall
of Rt. 2 - Box 378 Eugene, Ore. County of Lane
(Mailing address)

State of Oregon, do hereby make application for a certificate of registration as evidence of a right to appropriate ground water.

1. Source from which water is withdrawn is Pump well #1
(Flowing well, pump well, infiltration trench, or tunnel)

2. Location is: 3/4 miles S.W. Coburg, Oregon
(Approximate distance and direction from nearest city or town)

and is more particularly described as follows: 1600' North & 1350' South East of South west corner sec.

(a) 1600' North & 1350' South East of South west corner sec.
(Give distance and bearing to corner of section or other legal subdivision)

being within NW 1/4 of SW 1/4 of Sec. 32, Twp. 16 S, Rge. 3 W
(Smallest legal subdivision) (N. or S.) (E. or W.)

or (b) within limits of recorded platted property, town or city:

in Lot _____ Block _____ of _____
(Name of plat or addition)

(If within city or town, give name) County of Lane

3. Construction Work was begun on June 1930; was completed on June 1930
(Date) (Date)

and the ground water claimed was first used for the purposes set out below on June 1930
(Date)

since which time the water has been used Intermittently
(Continuously or intermittently)

from 1930 to Present
(Date) (Date)

4. Quantity of water claimed and used is 250 gallons per minute; 35 acre feet per year.

5. Purpose or Purposes for which water is used Irrigation

(Domestic, irrigation, municipal, manufacturing, industrial, etc.)

6. Description of Well: Depth 18' feet. Type Driven
(Dug or drilled)

diameter (3) 2" inches. Elevation of ground at well site 335 feet, mean sea level.
(As near as known)

Depth to water table 10 feet.

7. Capacity of Well: 250 g.p.m. with 0 feet drawdown.

_____ g.p.m. with _____ feet drawdown.

Date of test observation


If Flowing Well: Measured discharge _____ g.p.m. on _____
(Date)

Shut-in pressure at ground surface _____ lbs. per sq. in. on _____
(Date)

Water is controlled by _____
(Cap, valve, etc.)

Township 16S Range 3W W.M.

North

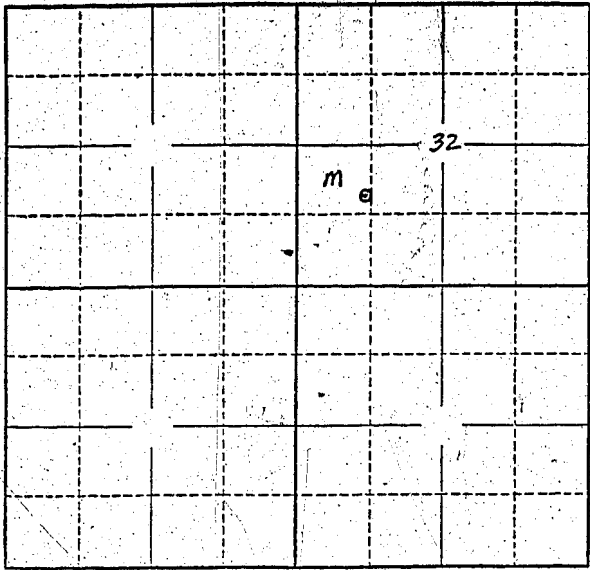

Locate well and acreage of irrigated land on plat.

Scale: 2" = 1 Mile

STATE OF OREGON

County of Marion } ss.

I, _____, being first duly sworn, do hereby certify that I have read the foregoing Registration Statement and that all of the items therein contained are true to the best of my knowledge and belief.

Fred J. Mendemhall
(Signature of Registrant)

Subscribed and sworn to before me this 1st day of April, 19 58

My commission expires 12th June 1961

Wm. S. Bartholomew
(Notary Public)

(SEAL)

CERTIFICATE OF REGISTRATION

STATE OF OREGON

County of Marion } ss.

This is to certify that the foregoing Registration Statement was received in the office of the State Engineer on the 7th day of April, 1958, at 8:00 o'clock AM and has been duly recorded in said office in Book No. 6 of Registration Statements on page GR-1317

Witness my hand this 20th day of October, 1958

Lewis A. Stanley
(State Engineer)

By _____ (Deputy)