

Registration Statement

OF CLAIMANT OF RIGHT TO APPROPRIATE GROUND WATER

(Under Chapter 708, Oregon Laws 1955.)

TO THE STATE ENGINEER OF OREGON:

I, JOHN LAUNDERBACK

of WALTON County of WALTON

State of Oregon, do hereby make application for a certificate of registration as evidence of a right to appropriate ground water.

1. Source from which water is withdrawn is Dump Well
(Flowing well, pump well, infiltration trench, or tunnel)

2. Location is: 9 mi. NE of S. 1st St. at Lawrence Road
(Approximate distance and direction from nearest city or town)

and is more particularly described as follows:

(a) 7 Charles West subdivision, section 14, township 7 N, range 2 W
(Give distance and bearing to corner of section or other legal subdivision)

being within NE 1/4 of Sec. 14, Twp. 7, Rge. 2 W
(Smallest legal subdivision) (N. or S.) (E. or W.)

or (b) within limits of recorded platted property, town or city:

in Lot _____, Block _____ of _____
(Name of plat or addition)

County of _____
(If within city or town, give name)

3. Construction Work was begun on Dec 53, was completed on Jan 14 54
(Date) (Date)

and the ground water claimed was first used for the purposes set out below on April 1954
(Date)

since which time the water has been used Intermittently
(Continuously or intermittently)

from March to Sept
(Date) (Date)

4. Quantity of water claimed and used is 220 gallons per minute; _____ acre feet per year.

5. Purpose or Purposes for which water is used Irrigation

(Domestic, irrigation, municipal, manufacturing, industrial, etc.)

6. Description of Well: Depth _____ feet. Type Hand-dug
(Dug or drilled)

diameter _____ inches. Elevation of ground at well site _____ feet, mean sea level.
(As near as known)

Depth to water table _____ feet.

7. Capacity of Well: 100 g.p.m. with 12 feet drawdown.

220 g.p.m. with 24 feet drawdown.

Date of test June 1954

If Flowing Well: Measured discharge _____ g.p.m. on _____
(Date)

Shut-in pressure at ground surface _____ lbs. per sq. in. on _____
(Date)

Water is controlled by _____
(Cap, valve, etc.)

If log of well is not available, give name and address of driller. Rudolph Stadlie

11. Infiltration Trench: Covered or open
 Dimensions: Length ft. Minimum depth ft. Maximum depth ft.
 Bottom width ft. Discharge g.p.m. Date of test

12. Tunnel: Type of lining
 Dimensions:
(Length, course, and cross sectional size)
 Position of water bearing stratum with reference to portal of tunnel

Log of tunnel: (Preceding table for log of well may be used, if desired. Give footage from portal and character of materials, as pertinent.)


13. Pumping Equipment:
 (a) Pump L 217 D 2 N.H.S. Morse Capacity 220 g.p.m.
(Make, type and size)
 (b) Motor 15 H.P.
(Type and horsepower)

14. Location of area irrigated or to be irrigated, or place of use if for purposes other than irrigation.

Township North or South	Range E. or W. of Willamette Meridian	Section	Forty-acre Tract	Number Acres To Be Irrigated	Date of Reclamation
<u>F 1 S</u>	<u>R. 3 W</u>	<u>14</u>	<u>NE 1/4 of NW 1/4</u>	<u>1.25</u>	<u>May 1954</u>
"	"	<u>14</u>	<u>SE 1/4 of NW 1/4</u>	<u>1.25</u>	<u>May 1954</u>
"	"	<u>11</u>	<u>SE 1/4 of SW 1/4</u>	<u>5.5</u>	<u>May 1957</u>
"	"	<u>11</u>	<u>SW 1/4 of SE 1/4</u>	<u>4.5</u>	<u>May 1957</u>

15. If the ground water supply is supplemental to an existing water supply, identification of any application for a permit, permit, certificate or adjudicated right to appropriate water made or held by the registrant.

Township T. 7 S. Range R. 9 W. W.M.
North

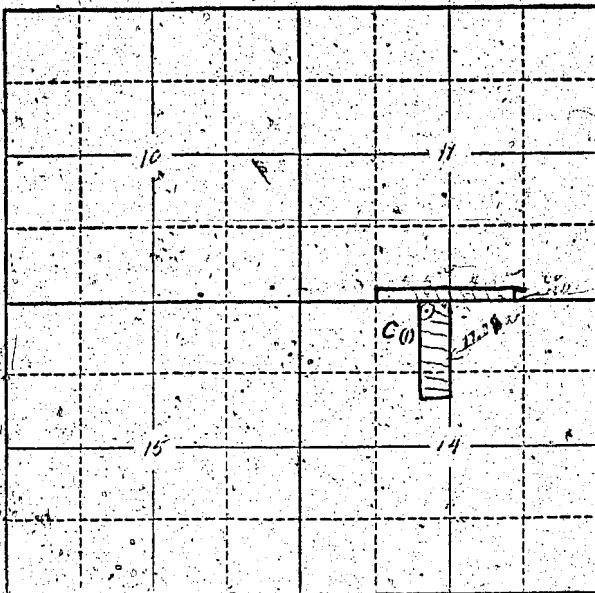

Locate well and acreage of irrigated land on plat.

Scale: 2" = 1 Mile

STATE OF OREGON

County of _____ } ss.

I, John Lauderback, being first duly sworn, do hereby certify that I have read the foregoing Registration Statement and that all of the items therein contained are true to the best of my knowledge and belief.

John Lauderback
(Signature of Registrant)

Subscribed and sworn to before me this 2nd day of March, 1956

My commission expires _____ (Notary Public)

(SEAL)

CERTIFICATE OF REGISTRATION

STATE OF OREGON } ss.
County of Marion

This is to certify that the foregoing Registration Statement was received in the office of the State Engineer on the 2nd day of March, 1956, at 1:00 o'clock P. M. and has been duly recorded in said office in Book No. 1 of Registration Statements on page GR-127C

~~Construction shall be completed by~~ October 1, 1958 and the water/completely applied to beneficial use by October 1, 1958. shall be

Witness my hand this 12th day of April, 1956

Leuro A. Stanley
(State Engineer)

By _____ (Deputy)