

OF CLAIMANT OF RIGHT TO APPROPRIATE GROUND WATER

(Under Chapter 708, Oregon Laws 1955.)

TO THE STATE ENGINEER OF OREGON:

I, Edward F. & Wilmetta Schroederof Rt .1 Box 29 ,Dayton County of YamhillState of Oregon, do hereby make application for a certificate of registration as evidence of a right to appropriate ground water.1. Source from which water is withdrawn is Pump well when irrigating

(Flowing well, pump well, infiltration trench, or tunnel)

2. Location is: Four miles south by west of Dayton, Oregon

(Approximate distance and direction from nearest city or town)

and is more particularly described as follows:

(a) 450 feet south, 2500 feet east , of the NW corner Sec. 6, T5S, R3W

(Give distance and bearing to corner of section or other legal subdivision)

being within NE $\frac{1}{4}$ NW $\frac{1}{4}$ of Sec. 6, Twp. 5S, Rge. 3W

(Smallest legal subdivision)

(N. or S.)

(E. or W.)

or (b) within limits of recorded platted property, town or city:

in Lot _____, Block _____ of _____

(Name of plat or addition)

(If within city or town, give name)

County of _____

3. Construction Work was begun on July 1947; was completed on July 1947

(Date)

(Date)

and the ground water claimed was first used for the purposes set out below on July 1948

(Date)

since which time the water has been used continuously

(Continuously or intermittently)

from 1948 to present

(Date)

(Date)

4. Quantity of water claimed and used is 80 gallons per minute; _____ acre feet per year.5. Purpose or Purposes for which water is used irrigation

(Domestic, irrigation, municipal, manufacturing, industrial, etc.)

6. Description of Well: Depth 80 feet. Type drilled - casing

(Dug or drilled)

diameter 6" inches. Elevation of ground at well site 155 feet, mean sea level.

(As near as known)

Depth to water table 0 feet. At surface7. Capacity of Well: 80 g.p.m. with 50 feet drawdown.

_____ g.p.m. with _____ feet drawdown.

Date of test experience when irrigating

If Flowing Well: Measured discharge _____ g.p.m. on _____

(Date)


Shut-in pressure at ground surface _____ lbs. per sq. in. on _____

(Date)

Water is controlled by _____

(Cap, valve, etc.)

Township 55 Range 3W W.M.
North

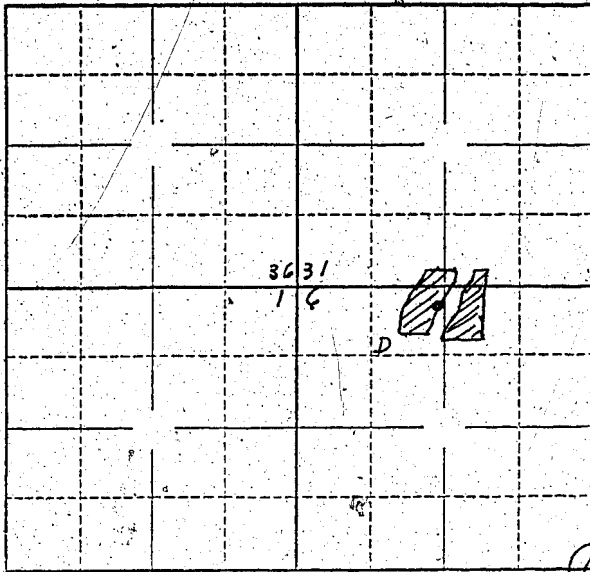

Locate well and acreage of irrigated land on plat.

Scale: 2" = 1 Mile
4"

STATE OF OREGON

County of Yamhill

ss.

I, Edward F. & Wilnetta Schroeder, being first duly sworn, do hereby certify that I have read the foregoing Registration Statement and that all of the items therein contained are true to the best of my knowledge and belief.

Edward F. Schroeder
Wilnetta Schroeder
(Signature of Registrant)

Subscribed and sworn to before me this 21st day of March, 1958.

My commission expires May 23, 1960

(Notary Public)

(SEAL)

CERTIFICATE OF REGISTRATION

STATE OF OREGON

County of Marion

ss.

This is to certify that the foregoing Registration Statement was received in the office of the State Engineer on the 7th day of April, 1958, at 3:30 o'clock P. M. and has been duly recorded in said office in Book No. 6 of Registration Statements on page GR-1331

~~Construction shall be completed by 10/19/58 and the water completely applied for beneficial use by 10/19/58.~~

Witness my hand this 20th day of October, 1958.

Lewis A. Stanley
(State Engineer)

By

(Deputy)

GR-1331

\$ 15.00