

RECEIVED

APR 7 1953

STATE ENGINEER
SALEM, OREGON

Registration No. GR. 1374

Certificate No. GR. 1402

Registration Statement

OF CLAIMANT OF RIGHT TO APPROPRIATE GROUND WATER

TO THE STATE ENGINEER OF OREGON:

I, James B. Crowson and Sarah Frances Crowson (Husband & Wife)

of 525 Lake Lake Rd - Junction City County of Lane

State of Oregon, do hereby make application for a certificate of registration as evidence of a right to appropriate ground water.

1. Source from which water is withdrawn is Pump Well
(Flowing well, pump well, infiltration trench, or tunnel)

2. Location is: 2.0 Miles East of Junction City
(Approximate distance and direction from nearest city or town)

and is more particularly described as follows:

(a) 2250' N. & 2300' E.
1.4 Miles N. 47° E. of S.W. Cor. Sec. 33
(Give distance and bearing to corner of section or other legal subdivision)

being within N.E. 1/4 of Sec. 33 of Sec. 33, Twp. 15 S, Rge. 4 W
(Smallest legal subdivision) (N. or S.) (E. or W.)

or (b) within limits of recorded platted property, town or city:

in Lot _____, Block _____ of _____
(Name of plat or addition)

County of _____
(If within city or town, give name)

3. Construction Work was begun on 1953; was completed on 1953
(Date) (Date)

and the ground water claimed was first used for the purposes set out below on June 1953
(Date)

since which time the water has been used intermittently
(Continuously or Intermittently)

from June 1953 to 1957
(Date) (Date)

4. Quantity of water claimed and used is 370 gallons per minute; 4.0 acre feet per year.

5. Purpose or Purposes for which water is used irrigation

(Domestic, irrigation, municipal, manufacturing, industrial, etc.)

6. Description of Well: Depth 24 feet. Type Driven
(Dug or drilled)

diameter 5 inches. Elevation of ground at well site 319 feet, mean sea level.
(As near as known)

Depth to water table 14 feet.

7. Capacity of Well: 370 g.p.m. with 1 feet drawdown.

_____ g.p.m. with _____ feet drawdown.

Date of test _____


If Flowing Well: Measured discharge _____ g.p.m. on _____
(Date)

Shut-in pressure at ground surface _____ lbs. per sq. in. on _____
(Date)

Water is controlled by _____
(Cap, valve, etc.)

Township 155 Range 4W W.M.

North

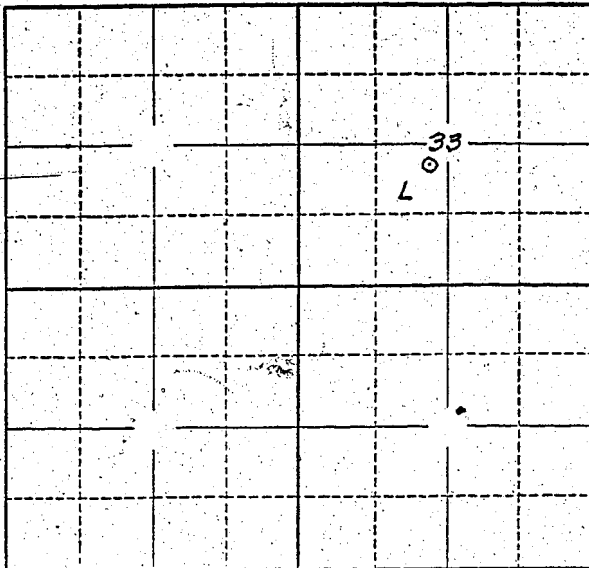

Locate well and acreage of irrigated land on plat.

Scale: 2" = 1 Mile

STATE OF OREGON

County of Lane } ss.

I, James B. Crowson and Sarah Frances Crowson, being first duly sworn, do hereby certify that I have read the foregoing Registration Statement and that all of the items therein contained are true to the best of my knowledge and belief.

James B. Crowson Sarah Frances Crowson
(Signature of Registrant)

Subscribed and sworn to before me this 13th day of April 19 58

My commission expires March 13, 1961

Dwight M. Lane
(Notary Public)

(SEAL)

CERTIFICATE OF REGISTRATION

STATE OF OREGON }
County of Marion } ss.

This is to certify that the foregoing Registration Statement was received in the office of the State Engineer on the 7th day of April, 1958, at 3:00 o'clock P.M. and has been duly recorded in said office in Book No. 17 of Registration Statements on page GR-1402

Witness my hand this 20th day of October 19 58

\$ 15.00

Lewis A. Stanley
(State Engineer)

By _____ (Deputy)

GR-1402