

RECEIVED
APR 8 1958
STATE ENGINEER
SALEM, OREGON

Registration No. GR - 1375
Certificate No. GR - 1332

Registration Statement

OF CLAIMANT OF RIGHT TO APPROPRIATE GROUND WATER

TO THE STATE ENGINEER OF OREGON:

I, CLARENCE & HAZEL BOND

of 6265 RIVER ROAD, JUNCTION CITY County of LANE
(Mailing address)

State of OREGON, do hereby make application for a certificate of registration as evidence of a right to appropriate ground water.

1. Source from which water is withdrawn is PUMP WELL
(Flowing well, pump well, infiltration trench, or tunnel)

2. Location is: NORTH OF EUGENE 8 MILES
(Approximate distance and direction from nearest city or town)

and is more particularly described as follows:

(a) 1030' N 73° 20' E OF THE SW COR. OF S.E.S. 26
(Give distance and bearing to corner of section or other legal subdivision)

being within SW 1/4 SW 1/4 of Sec. 26, Twp. 26S, Rge. 4W
(Smallest legal subdivision) (N. or S.) (E. or W.)

or (b) within limits of recorded platted property, town or city:

in Lot _____, Block _____ of _____
(Name of plat or addition)

_____ County of _____
(If within city or town, give name)

3. Construction Work was begun on APRIL 1936; was completed on APRIL 1936
(Date) (Date)

and the ground water claimed was first used for the purposes set out below on JUNE 1936
(Date)

since which time the water has been used CONTINUOUSLY
(Continuously or intermittently)

from JUNE 1936 to SEPT 1957
(Date) (Date)

4. Quantity of water claimed and used is 325 gallons per minute; 115 acre feet per year.

5. Purpose or Purposes for which water is used Irrigation

(Domestic, irrigation, municipal, manufacturing, industrial, etc.)

6. Description of Well: Depth 30 feet. Type DRILLED
(Dug or drilled)

diameter 12 inches. Elevation of ground at well site 420 feet, mean sea level.
(As near as known)

Depth to water table 6 feet.

7. Capacity of Well: 325 g.p.m. with 2 feet drawdown.

_____ g.p.m. with _____ feet drawdown.


Date of test _____

If Flowing Well: Measured discharge _____ g.p.m. on _____
(Date)

Shut-in pressure at ground surface _____ lbs. per sq. in. on _____
(Date)

Water is controlled by _____
(Cap, valve, etc.)

Township 16S Range 4W W.M.
North

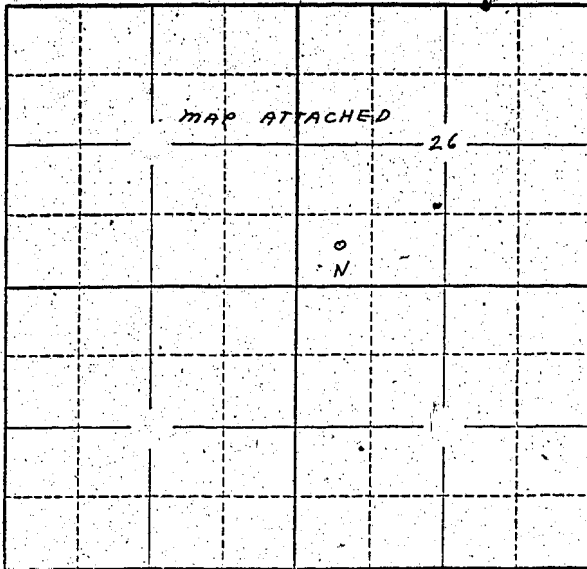

Locate well and acreage of irrigated land on plat.
Scale: 2" - 1 Mile

STATE OF OREGON

County of Lane } ss.

I, FRED BROUGHTER, being first duly sworn, do hereby certify that I have read the foregoing Registration Statement and that all of the items therein contained are true to the best of my knowledge and belief.

Fred Broughter
(Signature of Registrant)

Subscribed and sworn to before me this 7th day of April, 1958

My commission expires Sept 29, 1960 D. S. Young
(Notary Public)

(SEAL)

CERTIFICATE OF REGISTRATION

STATE OF OREGON

County of Marion } ss.

This is to certify that the foregoing Registration Statement was received in the office of the State Engineer on the 8th day of April, 1958, at 8:00 o'clock A.M. and has been duly recorded in said office in Book No. 6 of Registration Statements on page GR-1332

Witness my hand this 20th day of October, 1958

Lewis A. Stanley
(State Engineer)

By _____
(Deputy)