

RECEIVED  
APR 8 1958  
STATE ENGINEER  
SALEM, OREGON

# Registration Statement

REGISTRATION NO. GR-1379  
CERTIFICATE NO. GR-1336

## OF CLAIMANT OF RIGHT TO APPROPRIATE GROUND WATER

(Under Chapter 708, Oregon Laws 1955.)

TO THE STATE ENGINEER OF OREGON:

I, Annie Emma Pilkington and Mary Agnes Pilkington  
of Corvallis County of Benton

State of Oregon, do hereby make application for a certificate of registration as evidence of a right to appropriate ground water.

1. Source from which water is withdrawn is pump well  
(Flowing well, pump well, infiltration trench, or tunnel)
2. Location is: 4 miles northeast of Corvallis  
(Approximate distance and direction from nearest city or town)

and is more particularly described as follows:

(a) 21.50 chains North and 33.00 chains East of the SW corner of the Jehiel S. Kendall D.L.C. #48, Twp. 11 S., R. 4 W.  
being within NE 1/4 of SE 1/4 of Sec. 19, Twp. 11 S., Rge. 4 W.  
(Smallest legal subdivision) (N. or S.) (E. or W.)

or (b) within limits of recorded platted property, town or city:  
in Lot \_\_\_\_\_, Block \_\_\_\_\_ of \_\_\_\_\_  
(Name of plat or addition)

County of \_\_\_\_\_  
(If within city or town, give name)

3. Construction Work was begun on July 1941; was completed on July 1941  
(Date) (Date)  
and the ground water claimed was first used for the purposes set out below on July 1941  
(Date)  
since which time the water has been used continuously  
(Continuously or Intermittently)  
from July 1941, to date  
(Date) (Date)

4. Quantity of water claimed and used is 10 gallons per minute; \_\_\_\_\_ acre feet per year.

5. Purpose or Purposes for which water is used Domestic and irrigation of nursery stock.  
(Domestic, irrigation, municipal, manufacturing, industrial, etc.)

6. Description of Well: Depth 47 feet. Type drilled  
(Dug or drilled)  
diameter 4 inches. Elevation of ground at well site 210 feet, mean sea level.  
(As near as known)  
Depth to water table 28 feet, estimated.

7. Capacity of Well: 10 g.p.m. with unknown feet drawdown.  
\_\_\_\_\_ g.p.m. with \_\_\_\_\_ feet drawdown.

Date of test July 1941

If Flowing Well: Measured discharge \_\_\_\_\_ g.p.m. on \_\_\_\_\_  
(Date)

Shut-in pressure at ground surface \_\_\_\_\_ lbs. per sq. in. on \_\_\_\_\_  
(Date)

Water is controlled by \_\_\_\_\_  
(Cap, valve, etc.)

8. Casing: (Give diameter, commercial specifications and depth below ground surface of each casing size.)

well 47 feet deep

|                              |            |          |      |
|------------------------------|------------|----------|------|
| ..... 4. inch diameter ..... | from ..... | to ..... | feet |
| ..... inch diameter .....    | from ..... | to ..... | feet |
| ..... inch diameter .....    | from ..... | to ..... | feet |
| ..... inch diameter .....    | from ..... | to ..... | feet |

Describe and show depth of shoe, plug, adapter, liner or other details: unknown

9. Perforated Casings or Screens:

|   |            |          |
|---|------------|----------|
| ..... Perforated casing, number & size unknown .....                          | from ..... | to ..... |
| <small>(Number per foot and size of perforations, or describe screen)</small> |            |          |
| .....   | from ..... | to ..... |
| .....   | from ..... | to ..... |
| .....   | from ..... | to ..... |

10. Log of Well: (Describe each stratum or formation clearly, indicate if water bearing, and give thickness and depth as indicated.)

| MATERIAL      | Thickness<br>(Feet) | Depth to Bottom<br>(Feet) |
|---------------|---------------------|---------------------------|
| Not available |                     |                           |
|               |                     |                           |
|               |                     |                           |
If log of well is not available, give name and address of driller. Mr. Knudson - this well was drilled in 1941. We are unable to locate Mr. Knudson in Benton County.

11. Infiltration Trench: Covered or open .....

Dimensions: Length ..... ft. Minimum depth ..... ft. Maximum depth ..... ft.

Bottom width ..... ft. Discharge ..... g.p.m. Date of test .....

12. Tunnel: Type of lining .....

Dimensions: .....  
(Length, course, and cross sectional size)

Position of water bearing stratum with reference to portal of tunnel .....

Log of tunnel: (Preceding table for log of well may be used, if desired. Give footage from portal and character of materials, as pertinent.)

13. Pumping Equipment:

(a) Pump Westco ..... Capacity 15 g.p.m.  
(Make, type and size)


(b) Motor 1/2 hp electric .....  
(Type and horsepower)

14. Location of area irrigated or to be irrigated, or place of use if for purposes other than irrigation.

| Township North or South      | Range E. or W. of Willamette Meridian | Section | Forty-acre Tract                     | Number Acres To Be Irrigated | Date of Reclamation |
|------------------------------|---------------------------------------|---------|--------------------------------------|------------------------------|---------------------|
| 11 S.                        | 4 W.                                  | 19      | SE $\frac{1}{4}$ of NE $\frac{1}{4}$ | 6.6                          | 1941                |
|                              |                                       |         | NE $\frac{1}{4}$ of SE $\frac{1}{4}$ | 5.0                          | "                   |
|                              |                                       | 20      | NW $\frac{1}{4}$ of SE $\frac{1}{4}$ | 0.4                          | "                   |
|                              |                                       |         | Sw $\frac{1}{4}$ of NW $\frac{1}{4}$ | 1.4                          | "                   |
|                              |                                       |         | 13.4                                 |                              |                     |
| Auxiliary to Permit No. .... |                                       |         |                                      |                              |                     |
|                              |                                       |         |                                      |                              |                     |
15. If the ground water supply is supplemental to an existing water supply, identification of any application for a permit, permit, certificate or adjudicated right to appropriate water made or held by the registrant.

Township 115 Range 4W, W.M.  
North

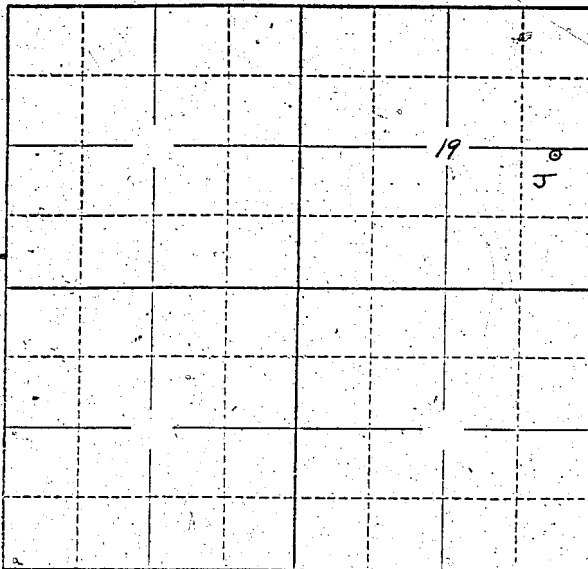

Locate well and acreage of irrigated land on plat.

Scale: 2" = 1 Mile

STATE OF OREGON

County of Benton

} ss.

Annie Emma Pilkington and

I, Mary Agnes Pilkington

, being first duly sworn, do hereby certify that I have read the foregoing Registration Statement and that all of the items therein contained are true to the best of my knowledge and belief.

x Mary Agnes Pilkington  
x Annie Emma Pilkington  
(Signature of Registrant)

Subscribed and sworn to before me this 7th day of April, 1958

My commission expires July 20, 1960

James J. [Signature]  
(Notary Public)

(SEAL)

**CERTIFICATE OF REGISTRATION**

STATE OF OREGON

County of Marion

} ss.

This is to certify that the foregoing Registration Statement was received in the office of the State Engineer on the 2th day of April, 1958, at 8:00 o'clock A.M. and has been duly recorded in said office in Book No. 6 of Registration Statements on page GR-1336

~~Witness my hand and seal this 19th day of April, 1958, at [illegible] Oregon.~~

Witness my hand this 20th day of October, 1958

Ruth A. [Signature]  
(State Engineer)

By \_\_\_\_\_  
(Deputy)

GR-1336