

RECEIVED

APR 9 1958

STATE ENGINEER
SALEM, OREGON

Registration No. GR 1385

Certificate No. GR 1342

Registration Statement

OF CLAIMANT OF RIGHT TO APPROPRIATE GROUND WATER

TO THE STATE ENGINEER OF OREGON:

I, Fred Hills

of Rt 1 Bar 42 Springfield County of Lane

State of Oregon, do hereby make application for a certificate of registration as evidence of a right to appropriate ground water.

1. Source from which water is withdrawn is Pump well #1
(Flowing well, pump well, infiltration trench, or tunnel)

2. Location is: 2 1/2 MI E Springfield
(Approximate distance and direction from nearest city or town)

and is more particularly described as follows:

(a) 380' N 7 1/2' E 1420' West of East 1/2 cor Sec 6 T18S, R 2W - 2 1/2 Acres
(Give distance and bearing to corner of section or other legal subdivision)

being within SW 1/4 of NE 1/4 of Sec 6 of Sec. 6, Twp. T18S, Rge. 2W
(Smallest legal subdivision) (N. or S.) (E. or W.)

or (b) within limits of recorded platted property, town or city:

in Lot _____, Block _____ of _____

(Name of plat or addition)

County of Lane

(If within city or town, give name)

3. Construction Work was begun on June 1943; was completed on 1943
(Date) (Date)

and the ground water claimed was first used for the purposes set out below on June 1943
(Date)

since which time the water has been used Summer months (intermittently)
(Continuously or intermittently)

from May to Oct
(Date) (Date)

4. Quantity of water claimed and used is 350 gallons per minute; 7.5 acre feet per year.

5. Purpose or Purposes for which water is used Irrigate Lawn

(Domestic, irrigation, municipal, manufacturing, industrial, etc.)

6. Description of Well: Depth 16' feet. Type Drilled
(Dug or drilled)

diameter 12" inches. Elevation of ground at well site 500 feet, mean sea level.
(As near as known)

Depth to water table 8' feet.

7. Capacity of Well: 350 g.p.m. with 6 feet drawdown.

_____ g.p.m. with _____ feet drawdown.


Date of test Observation

If Flowing Well: Measured discharge _____ g.p.m. on _____
(Date)

Shut-in pressure at ground surface _____ lbs. per sq. in. on _____
(Date)

Water is controlled by _____
(Cap, valve, etc.)

Township 18 S Range 2 W W.M.
North

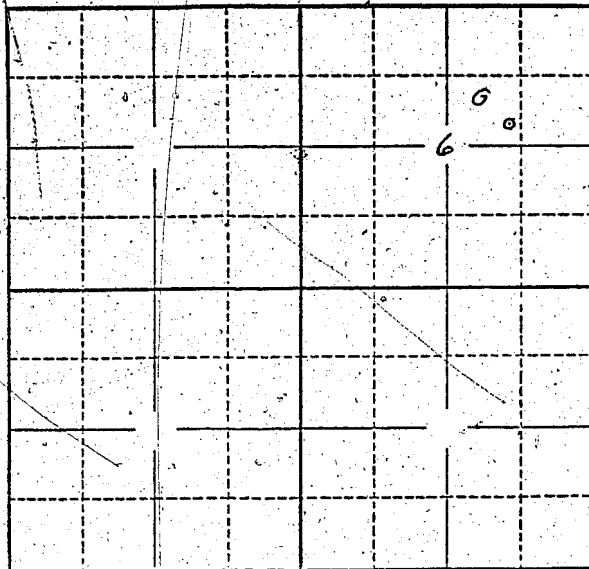

Locate well and acreage of irrigated land on plat.
Scale: 2" = 1 Mile

STATE OF OREGON

County of Marion } ss.

I, _____, being first duly sworn, do hereby certify that I have read the foregoing Registration Statement and that all of the items therein contained are true to the best of my knowledge and belief.

Fred Hills

(Signature of Registrant)

Subscribed and sworn to before me this 1st day of April, 19 58

My commission expires 12th June 1961

Wm. S. Bartholomew

(Notary Public)

(SEAL)

CERTIFICATE OF REGISTRATION

STATE OF OREGON }
County of Marion } ss.

This is to certify that the foregoing Registration Statement was received in the office of the State Engineer on the 9th day of April, 1958, at 10:30 o'clock A. M. and has been duly recorded in said office in Book No. 7 of Registration Statements on page 1312

Witness my hand this 20th day of October, 19 58

Lewis A. Stanley

(State Engineer)

By _____ (Deputy)

GR 1312

7/1500