

RECEIVED
APR 9 1958

STATE ENGINEER
SALEM OREGON

Registration No. GR. 1386

Certificate No. GR. 1343

Registration Statement

OF CLAIMANT OF RIGHT TO APPROPRIATE GROUND WATER

TO THE STATE ENGINEER OF OREGON:

I, JAMES L. KINCHELOE

of TR 2, BOX 461 BEAVERTON County of WASHINGTON

State of OREGON, do hereby make application for a certificate of registration as evidence of a right to appropriate ground water.

1. Source from which water is withdrawn is PUMP WELL
(Flowing well, pump well, infiltration trench, or tunnel)

2. Location is: 1 MILE SOUTH OF REEDVILLE, OREGON
(Approximate distance and direction from nearest city or town)

and is more particularly described as follows:

(a) 780' S 33° E from NW corner
(Give distance and bearing to corner of section or other legal subdivision)

being within NW 1/4 of SE 1/4 of Sec. 14, Twp. 15, Rge. 2 W
(Smallest legal subdivision) (N. or S.) (E. or W.)

or (b) within limits of recorded platted property, town or city:

in Lot _____, Block _____ of _____
(Name of plat or addition)

County of WASHINGTON
(If within city or town, give name)

3. Construction Work was begun on 1930; was completed on 1930
(Date) (Date)

and the ground water claimed was first used for the purposes set out below on 1930
(Date)

since which time the water has been used Continuously
(Continuously or Intermittently)

from 1930 to 1958
(Date) (Date)

4. Quantity of water claimed and used is 1.5 gallons per minute; 2 1/2 acre feet per year.

5. Purpose or Purposes for which water is used DOMESTIC, LIVESTOCK, IRRIGATION

(Domestic, irrigation, municipal, manufacturing, industrial, etc.)

6. Description of Well: Depth 16.5 feet. Type DRILLED
(Dug or drilled)

diameter 6 inches. Elevation of ground at well site Approx. 200' feet, mean sea level.
(As near as known)

Depth to water table 30 feet.

7. Capacity of Well: _____ g.p.m. with _____ feet drawdown.

_____ g.p.m. with _____ feet drawdown.

Date of test Never tested

If Flowing Well: Measured discharge _____ g.p.m. on _____
(Date)

Shut-in pressure at ground surface _____ lbs. per sq. in. on _____
(Date)

Water is controlled by _____
(Cap, valve, etc.)

8. Casing: (Give diameter, commercial specifications and depth below ground surface of each casing size.)

6 inch diameter from 0 to 165 feet
 inch diameter from to feet
 inch diameter from to feet
 inch diameter from to feet

Describe and show depth of shoe, plug, adapter, liner or other details:

9. Perforated Casings or Screens:

(Number per foot and size of perforations, or describe screen) from to
 from to
 from to
 from to

10. Log of Well: (Describe each stratum or formation clearly, indicate if water bearing, and give thickness and depth as indicated.)

MATERIAL	Thickness (Feet)	Depth to Bottom (Feet)
NONE AVAILABLE		

If log of well is not available, give name and address of driller Auto Well

1600

11. Infiltration Trench: Covered or open

Dimensions: Length ft. Minimum depth ft. Maximum depth ft.
 Bottom width ft. Discharge g.p.m. Date of test

12. Tunnel: Type of lining

Dimensions:
(Length, course, and cross sectional size)

Position of water bearing stratum with reference to portal of tunnel

Log of tunnel: (Preceding table for log of well may be used, if desired. Give footage from portal and character of materials, as pertinent.)

13. Pumping Equipment:

(a) Pump Myers E-Jecto Capacity g.p.m.
(Make, type and size)


(b) Motor 3/4 HP Electric
(Type and horsepower)

14. Location of area irrigated or to be irrigated, or place of use if for purposes other than irrigation.

Township North or South	Range E. or W. of Willamette Meridian	Section	Forty-acre Tract	Number Acres To Be Irrigated	Date of Reclamation
<u>1S</u>	<u>2W</u>	<u>14</u>	<u>NW 1/4 of SE 1/4</u>	<u>1⁰⁰</u>	<u>1930</u>

15. If the ground water supply is supplemental to an existing water supply, identification of any application for a permit, permit, certificate or adjudicated right to appropriate water made or held by the registrant.

Township 15 Range 2W W.M.
North

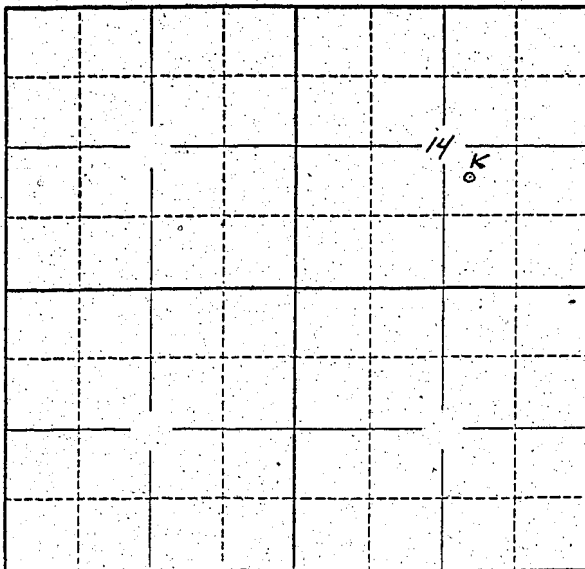

Locate well and acreage of irrigated land on plat.
Scale: 2" = 1 Mile

STATE OF OREGON

County of _____

} ss.

I, JAMES L. KINCHLO, being first duly sworn, do hereby certify that I have read the foregoing Registration Statement and that all of the items therein contained are true to the best of my knowledge and belief.

James L. Kinchlo
(Signature of Registrant)

Subscribed and sworn to before me this 26th day of March, 19 58

My commission expires 12th June 1961

Wm. S. Bartholmeus
(Notary Public)

(SEAL)

CERTIFICATE OF REGISTRATION

STATE OF OREGON

County of Marion

} ss.

This is to certify that the foregoing Registration Statement was received in the office of the State Engineer on the 7th day of April, 1958, at 10:30 o'clock A. M. and has been duly recorded in said office in Book No. 7 of Registration Statements on page GR-1343

Witness my hand this 20th day of October, 1958

Lewis A. Stanley
(State Engineer)

By _____

(Deputy)

GR-1343